


Map No. 1 Sec. 2 Twp. 31 R. 4E
 Well No. Wakefield Farm _____ Company _____

NORTH

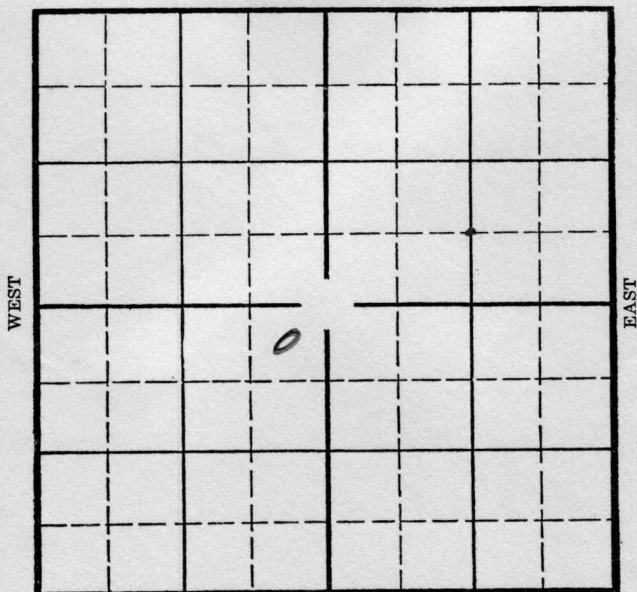

Location _____
 Drilling Remarks _____

Rig Up _____
 Drilling Remarks _____

RECORD

Cased _____ in. _____ ft.
 Sand _____
 Gas _____
 Oil _____
 Total Depth _____

PRODUCTION

1st 24 hrs. Nat. _____
 1st 24 hrs. after shot _____
 Gas _____ cu. ft. _____
 Dry Hole _____
 Abandoned _____

Cowley
4E

KANSAS

2

31

Map No. _____ Sec. _____ Twp. _____ R. _____

Well No. 1- Hanna Farm _____

Wakefield

Company _____

330

Ft. from N. Line


Ft. from S. Line

330

Ft. from E. Line

Ft. from W. Line

Elev. 1272

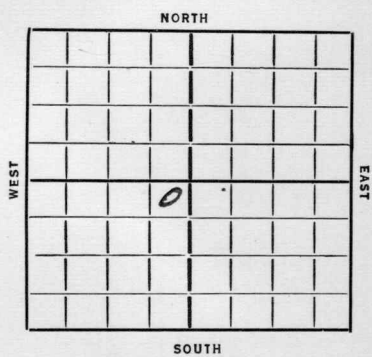

Date

REPORT

9/12 Location
10/3 400
10/19 1070
11/4 2355
11/7 8" 2545 TD 2660 S.D.
11/14 Part S. 2963 6" 2963
Pay 2975-89
Shovel 4 Bbls per hr
Will shoot
11/20 Sand 2963
TD 2989
70 ft / 157 Oil 1 wtr.

COMPLETED

Map No. 2 Sec. 2 Twp. 31 R. 4E

Well No. 1-Hanna

Wakefield Company

Contractor

SECTION PLAT

FIRST REPORTS

330 Ft. from N. Line

..... Ft. from S. Line

330 Ft. from E. Line

..... Ft. from W. Line

	0		

Location ☒

Rig up

Drilling and Remarks:

RECORD

Cased.....in.,ft.

Sand

Gas

Oil

Total Depth

PRODUCTION

1st 24 hrs. Nat.

1st 24 hrs. after shot

Gas.....Cu. Ft.

Dry Hole

Abandoned

Date

9-12-35 192

ORVAL MANNSCHRECK

Scout

Map No. 2 Sec. 2 Twp. 31 R. 4E

Well No. 1-Hanna

Wakefield Company

Contractor

COMPLETE

SECTION PLAT

330 Ft. from N. Line

..... Ft. from S. Line

330 Ft. from E. Line

..... Ft. from W. Line

	0		

Location.....

Rig up.....

Drilling and Remarks:

70 gts

157 oil
1 water

RECORD

Cased.....in.,ft.

Sand 2963

Gas.....

Oil.....

Total Depth 2989

PRODUCTION

1st 24 hrs. Nat.....

1st 24 hrs. after shot.....

Gas.....Cu. Ft.

Dry Hole.....

Abandoned.....

Date

11-30-35 192.....

ORVAL MANNSCHRECK

Scout