


Cowley KANSAS

DX 78-1

Section 2 Township 31 Range 1E

Well No. 8 David

Company E. F. Wakefield

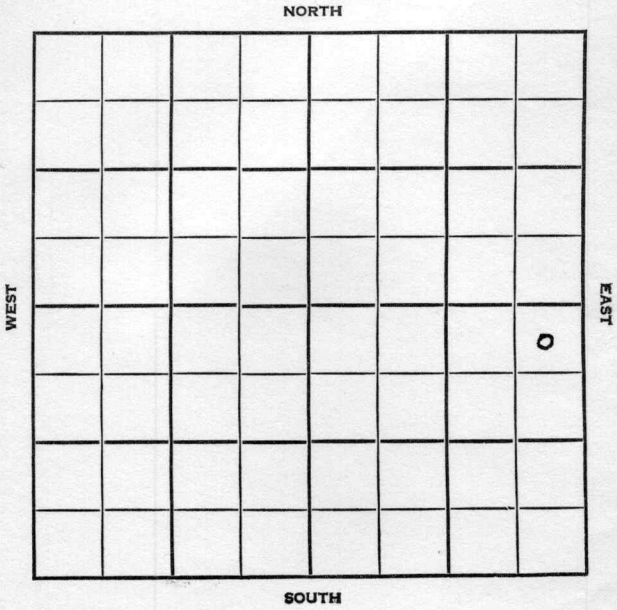

Cowley KANSAS

SEC.	TWP.	R.
2	31	4E

WELL NO. 8 David FARM

COMPANY E. F. Wakefield

CONTRACTOR Wakefield


NW David Pool

330 Ft. from N. Line

Ft. from S. Line

330 Ft. from E. Line

Ft. from W. Line

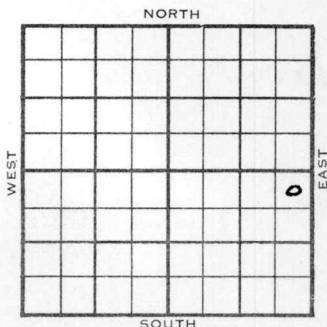

NE NE SE

1954	ELEVATION 1287	REPORT
------	----------------	--------

6/15	W OCT
7/14	Spdg 6-1954
	Oil well
	TD 2962
	8 " @ 95
	Bart 2940
	TD 2951
	5" @ 2941
	DD 2962 PB 2951 frac Comp. 25 bopd

COMPLETED

