


Section 2 Township 31 Range 4-E

Well No. #1 Hanna

Company E Wakefield

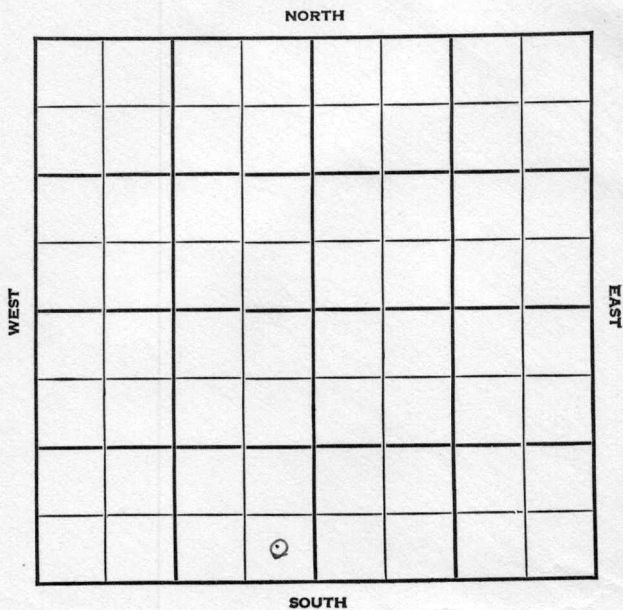

Sec. 2 Twp. 31 R. 4E

Well No. #1 Hanna Farm
E. Wakefield Company


Miscellaneous

_____ Ft. from N. Line

330' Ft. from S. Line

330' Ft. from E. Line

_____ Ft. from W. Line

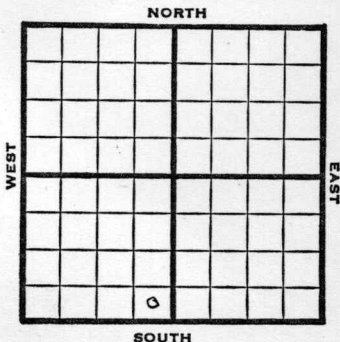

SE SW

1948

Elev. 1293' REPORT

6/30 Surface Hole
7/8 " "
7/14 9" @ 78'
Drlg 2190'
7/21 Drlg 2935'
7/28 Bart 2977'
TD 2980'
5" @ 2977'
8/4 TD 2998'
40 qts. 2980-97'
CO
8/11 Bart 2977'
5" @ 2977'
TD 2998'
40 qts 2980-90
Pump 10 oil Pot.
Gr. 41°

COMPLETED

Map No. _____ Sec. 2 Twp. 31 R. 4E

Well No. 1 Hanna

E. Wakefield Company

FIRST REPORT

Contractor

SE SW

SECTION PLAT

| | | | |
|--|--|--|--|
| | | | |
| | | | |
| | | | |
| | | | |
| | | | |

_____ Ft. from N. Line

330 Ft. from S. Line

330 Ft. from E. Line

_____ Ft. from W. Line

Cowley County

Location _____

Rig up _____

Drilling and Remarks:

surface hole

RECORD

Cased _____ in., _____ ft.

Sand _____

Gas _____

Oil _____

Total Depth _____

PRODUCTION

1st 24 hrs. Nat. _____

1st 24 hrs. after shot _____

Gas _____ Cu. Ft.

Dry Hole _____

Abandoned _____

Date

JUN 30 1948 19

S. J. LEWIS Scout

