


Section 2 Township 31 Range 4 E

Well No. # 7 Hanna

Company E. F. Wakefield

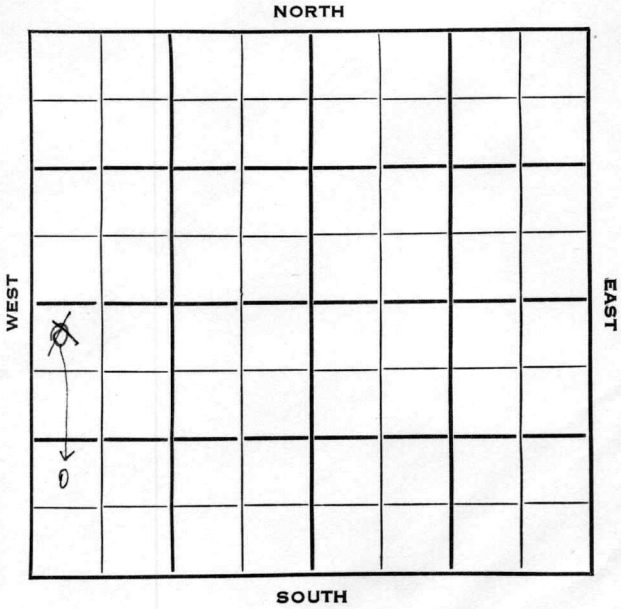

Cowley

KANSAS

SEC.	TWP.	R.
2	31	4E

WELL NO. _____

COMPANY #7 Hanna FARM

CONTRACTOR E.F. Wakefield


NW David Pool

~~330~~ Ft. from N. Line

990 Ft. from S. Line

_____ Ft. from E. Line

330 Ft. from W. Line

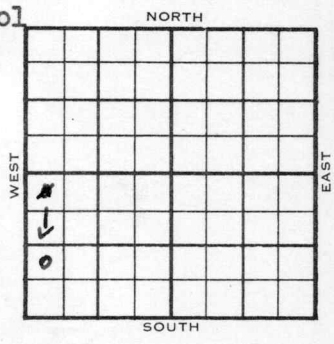

NW SW SW
~~NW NW SW~~

ELEVATION	REPORT
1953 1267'	

12/30 Surface Set

1954
 3/10 Spud 1-17-54
 Oil Well
 TD 2991'
 8" @ 80'
 Bart 2960'
 TD 2970'
 5" @ 2962'
 DD 2991' 2 bo 1/2 bw
 Sd-frac
 Hydro
 S/5 boph
 Comp. 25 bopd

COMPLETED

A 210888

Map No. _____ Sec. 2 Twp. 31 R. 4E

Well No. 7 Hanna

E. F. Wakefield Company

CORRECTION Contractor

NW SW SW

SECTION PLAT

_____ Ft. from N. Line

990 Ft. from S. Line

_____ Ft. from E. Line

330 Ft. from W. Line

o			

Cowley County

Location _____

Rig up _____

Drilling and Remarks:

Reported

NW NW SW

RECORD

Cased _____ in., _____ ft.

Sand _____

Gas _____

Oil _____

Total Depth _____

PRODUCTION

1st 24 hrs. Nat. _____

1st 24 hrs. after shot _____

Gas _____ Cu. Ft.

Dry Hole _____

Abandoned _____

Date

MAR 10 1954 19

J. G. McGEHEE Scout

x~~h~~ Hey Joe,

You reported this well in
NW NW SW. You complete in NW SW SW.
We have a #8 here. Which way do we go.

Luville R.

MAR 17 1954

Scout Cards	12
Land Small Map	
Land Wall Map	3
Tracings	
France Map	
Pierce Map	
Misc.	

Orig. Data