

KANSAS

McPherson

Form 51-5M-11-38-Palace

Section 31 Township 19 Range 1-W

Well No. #3 Lagree

Company H & M Drlg.

NORTH

5

0							

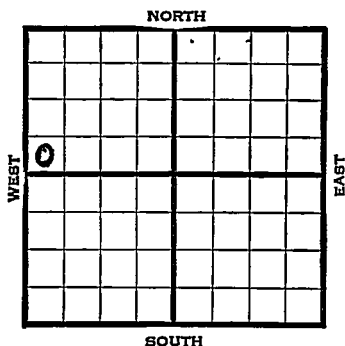
SOUTH

WEST

EAST

Sec. 31 Twp. 19 R. 1-WWell No. #3 Lagree FarmH & M Drlg. Company

(Ritz Canton)

 Ft. from N. Line320 Ft. from S. Line Ft. from E. Line400 Ft. from W. Line

1939	REPORT
7/26	Location
8/3	Mach.-Spud.
8/10	Spud 60'
8/17	15" - 92' Drlg. 605'
8/24	12" - 1075' Drlg. 1175'
8/31	10" - 1640' T.D. 1175' SD.
9/7	Drlg. 1975'
9/14	8" - 2250' Drlg. 2270'
9/21	Lans. 2312' 8" - 2429'
	Drlg. 2555'
9/28	Drlg. 2915'
10/5	Miss. 2929' 6" - 2929'
	T.D. 3004' U.R. 6".
10/12	3080' U.R. 6".
10/19	6" - 3087' Drlg. 3126'
	-
10/25	Viola 3398'
	S.O. & W.
	T.D. 3398½'
	ABANDONED

Map No. 43 Sec. 31 Twp. 19 R. 1WWell No. 3 Lagree

H & M Drlg.

Company

Contractor

FIRST REPORT

SW NW

 Ft. from N. Line320 Ft. from S. Line Ft. from E. Line400 Ft. from W. Line

RITZ CANTON POOL

SECTION PLAT

0			

Location X

RECORD

Cased in., ft.Sand Gas Oil Total Depth

PRODUCTION

1st 24 hrs. Nat. 1st 24 hrs. after shot Gas Cu. Ft.Dry Hole Abandoned Rig up Drilling and Remarks:

Date

JUL 26, 1939

19

E. H. WIS

Scout

Map No. 43 Sec. 31 Twp. 19 R. 1WWell No. 3 LagreeH & M Drilling

Company

Contractor

ABANDONED

SW NW

SECTION PLAT

0			

 Ft. from N. Line320 Ft. from S. Line Ft. from E. Line400 Ft. from W. Line

RITZ CANTON POOL

Location Rig up

Drilling and Remarks:

*Vista 3398**80xW.*

RECORD

Cased in., ft.Sand Gas Oil Total Depth 3398 1/2

PRODUCTION

1st 24 hrs. Nat. 1st 24 hrs. after shot Gas Cu. Ft.Dry Hole Abandoned

Date

OCT 2, 1939 19*E. J. L. 1115*

Scout