
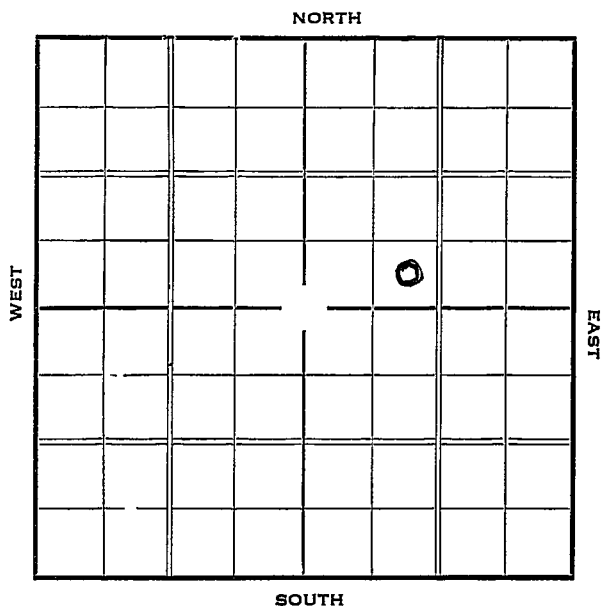


Section 31 Township 19 Range 1-WWell Number 3 SellersCompany H&M Drlg.

Sec. 31 Twp. 19 R. 1-WWell No. #3 Sellers FarmH & M. Drlg. Company Ft. from N. Line330 Ft. from S. Line Ft. from E. Line990 Ft. from W. Line

Elev. 1568

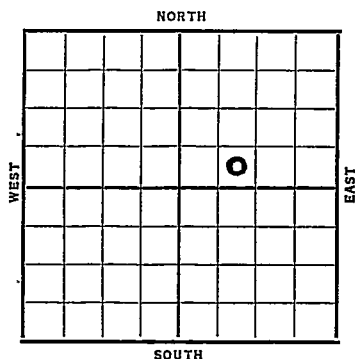

Date

REPORT

1937

4/14

Location

4/23

Mach. rigging up.

4/30

15" @ 110'. Drlg. 495'.

5/7

12" @ 832'. Drlg. 1550'.

5/14

Drlg. 2150'.

5/21

8" @ 2240'. Drlg. 2435'.

5/28

10" @ 1761'. Chat 2924'.

6" @ 2924'. Drlg. 2937'.

6/4

6" @ 2937'. T.D. 2947'. WOC

6/11

" " " " "

6/19

S.O. 2973'. Drlg. 2976'.

OVER

1937

6/23 6" @ 2937'.
Chat 2924'.
Pay 2974-79'.
T.D. 2979'.
1500 acid.
Flow 122 oil.
6 M gas.

COMPLETED

KANSAS *McPherson*Map No. _____ Sec. *31* Twp. *19* R. *1W*Well No. *3 Sec 11 ess**H. & M. Dalg* Company

Contractor

SECTION PLAT

_____ Ft. from N. Line

330 Ft. from S. Line

_____ Ft. from E. Line

990 Ft. from W. Line**FIRST REPORT**Location *✓*

Rig up _____

Drilling and Remarks:

RECORD

Cased _____ in., _____ ft.

Sand _____

Gas _____

Oil _____

Total Depth _____

PRODUCTION

1st 24 hrs. Nat. _____

1st 24 hrs. after shot _____

Gas _____ Cu. Ft.

Dry Hole _____

Abandoned _____

Date

APR 14 1937 ₁₉**S. J. LEWIS** Scout

KANSAS

Form 26—1M Bks.—2-29

McPherson

Map No. 43 Sec. 31 Twp. 19 R. 1 WWell No. 3-SellersH. & M. Dwyer Company

Contractor

COMPLETED

SECTION PLAT

		0	

_____ Ft. from N. Line

330 Ft. from S. Line

_____ Ft. from E. Line

990 Ft. from W. Line

Location _____

Rig up _____

Drilling and Remarks:

1500 AcidGet 122 oil6 m. gasflowing

RECORD

Cased 6 in., 2937 ft.Sand Chat 2924Gas Pay 2974-79

Oil _____

Total Depth 2979

PRODUCTION

1st 24 hrs. Nat. _____

1st 24 hrs. after shot _____

Gas _____ Cu. Ft.

Dry Hole _____

Abandoned _____

Date

JUN 23 1937 19 _____ H. D. Hatfield Scout