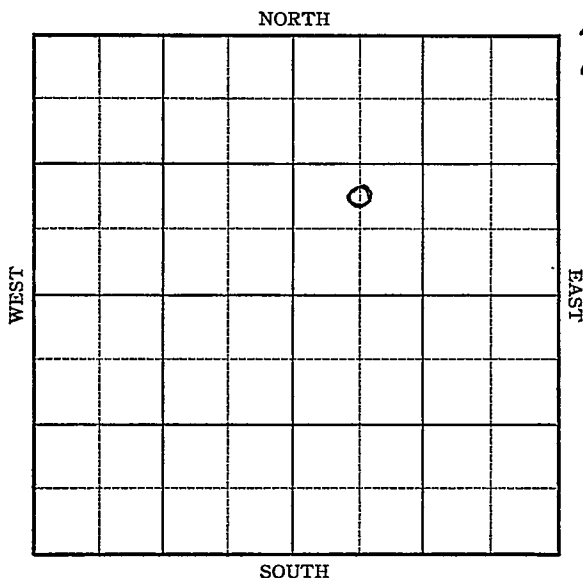
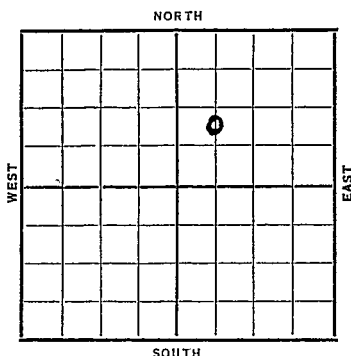


Section 31 Township 19 Range 1-WWell No. 4 SellarsCompany H & M. Drilling Co.

Sec. 31 Twp. 19 R. 1-WWell No. #4 Sellars FarmH & M Drilling Co. Company Ft. from N. Line990 Ft. from S. Line Ft. from E. Line660 Ft. from W. Line

Date	REPORT
1938	
1/12	R.U. Mach.
1/20	Spud
1/28	15" - 101' Drlg. 450'
2/4	12" - 830' Dlg. 995'
2/11	10" @ 1639'. Drlg. 1690'.
2/18	T.D. 2105'. Rng. 8".
2/26	8" @ 2275'. Drlg. 2350'.
3/4	Drlg. 2400'.
3/11	8" @ 2335'. 6" @ 2720'.
	Drlg. 2780'.
3/18	K.C. 2315'. H.F.W. 2330'.
	Chat 2900'. S.G. 2900-03' T.D.
	U. R. 6".
3/25	T.D. 2912'. U. R. 6".
4/1	T.D. 2950'. 6" @ 2945'. WOC.
4/8	6" @ 2908'. S.O. 2943-44'.
	Drlg. 2950'.
	OVER

1938

4/15 Pay 2967-78' T.D.
1800' oil $1\frac{1}{2}$ hrs.
4/22 1000 acid.

4/27 6" @ 2908'.
Chat 2900'.
T.D. 2978'.
1000 acid.
Potential 599 bbls. Show water

COMPLETED

Map No. 43 Sec. 31 Twp. 19 R. 1WWell No. 4 SellarsH & M Drilling Co. Company

Contractor

FIRST REPORT
C N L SW NE**SECTION PLAT**

		0	

 Ft. from N. Line990 Ft. from S. Line Ft. from E. Line660 Ft. from W. LineLocation Rig up

Drilling and Remarks:

R.U. Mach.

RECORDCased in., ft.Sand Gas Oil Total Depth **PRODUCTION**1st 24 hrs. Nat. 1st 24 hrs. after shot Gas Cu. Ft.Dry Hole Abandoned

Date

JAN 12 1938 19H. D. Hatfield Scout

McPherson KANSAS

Map No. 43 Sec. 31 Twp. 19 R. 1WWell No. 4 SellersH & M Drilling Co. Company

Contractor

COMPLETED

C N L SW NE

SECTION PLAT

		0	

4' Ft. from N. Line990 Ft. from S. Line

Ft. from E. Line

660 Ft. from W. Line

Location _____

Rig up _____

Drilling and Remarks:

1000 acid
POT 599
SW.

RECORD

Cased 6 in., 2908 ft.Sand chat 2900

Gas _____

Oil _____

Total Depth 2978

PRODUCTION

1st 24 hrs. Nat. _____

1st 24 hrs. after shot _____

Gas _____ Cu. Ft.

Dry Hole _____

Abandoned _____

Date

APR 27 1938

19

H. D. Hatfield

Scout