

Cowley

KANSAS

DX 78-1

Section 2 Township 31 Range 4E

Well No. #14 Hannah

Company E. Wakefield.

NORTH

WEST

EAST

	0						

SOUTH

Cowley

KANSAS

SEC.	TWP.	R.
2	31	4E

WELL NO. #14 Hannah FARM

COMPANY E. Wakefield

CONTRACTOR


David Pool

_____ Ft. from N. Line

990 _____ Ft. from S. Line

_____ Ft. from E. Line

990 _____ Ft. from W. Line

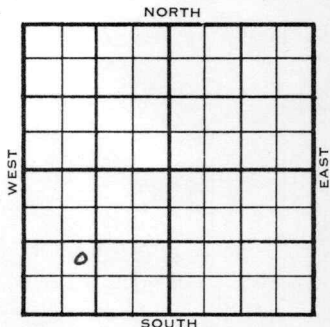

NE SW SW

1955	ELEVATION 1307'	REPORT
------	--------------------	--------

3/9 Spud 2-6-55
8" @ 100'
WOC

4/6 Spud 2-6-55
Oil Well
TD 3021'
8" @ 100'
Bart. 3012'
TD 3017'
5" @ 3012'
DD 3021' frac.
Comp 25 bopd.

COMPLETED

