

Section 9 Township 18 Range 10WWell No. 1 - AppelCompany ElReco

NORTH

				0			

WEST

EAST

SOUTH

Rice
18KANSAS
10

9

Sec. _____ Twp. _____ R. _____

Well No. #1 Appel Farm _____El Reco Company _____

Contractor _____

Bloomer Pool


330 Ft. from N. Line

_____ Ft. from S. Line

_____ Ft. from E. Line

330 Ft. from W. Line

NW NW NE

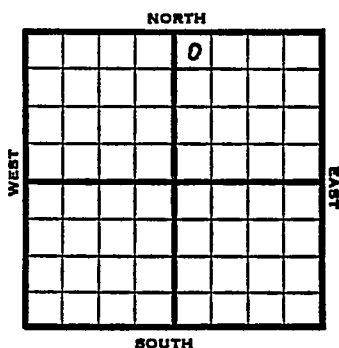

1953 Elev. 1790' REPORT

1/14 Spud 1-12-53
10" @ 215'

1/23 Spud 1-12-53
D&A
TD 3302
10" @ 215
Heeb 2822, Tor 2840, Br lime
2939, Lans 2955, Cong 3252,
Arb. 3273
TD 3302
D&A

ABANDONED

County Rice State KansasSec. 9 (Blk. Twp.) 18 (Sur. Rge.) 10W Map No.Operator ElRecoWell No. 1 Farm AppelElev. Location NW NW NE

			0		


FIRST REPORT

330 Ft. From N Line NE330 Ft. From W Line Quarter1st. Report JAN 14 1953

Completion

Remarks

Spudding Date 1-12-53Drlg. Data Bloomer Pool10" @ 215

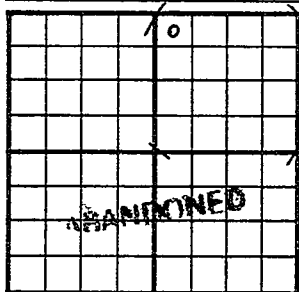County Rice State KansasSec. 9 (Blk.) 18 (Sur.) 10W Map No.Operator ElrecoWell No. 1 Farm AppelElev. 1790 Location NW NW NE

330 Ft. From N Line NE

330 Ft. From W Line Quarter

1st. Report

Completion JAN 23 1953Remarks Bloomer PoolSpudding Date 1-12-53Drig. Data D & A TD 330210" @ 215 Heeb. 2822 Tor. 2840Br. lime 2939 Lans. 2955 Cong. 3252Arb. 3273 TD 3302D & A