


Section 8 Township 18 Range 10W

Well No. #3 Heinz

Company Stagg Drlg.

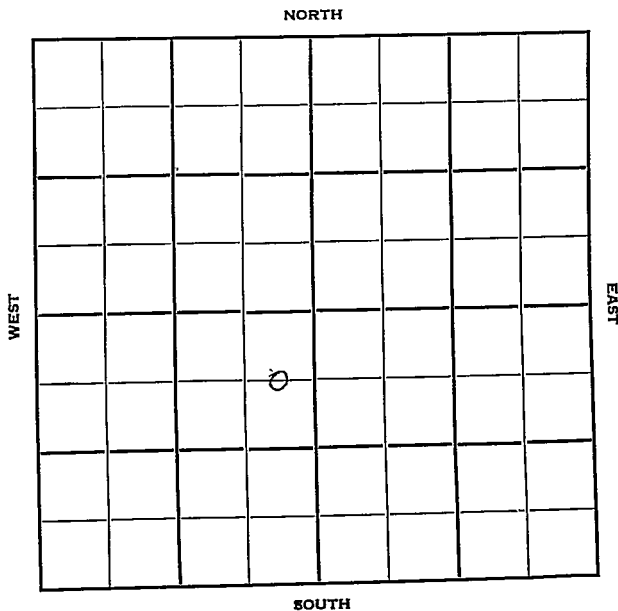

Rice
18

Sec. 8 Twp. 18 R. 10W

Well No. #3 Heinz Farm

Stagg Drlg. Company


Heinz Pool Contractor

660' Ft. from N. Line

Ft. from S. Line

330' Ft. from E. Line

Ft. from W. Line

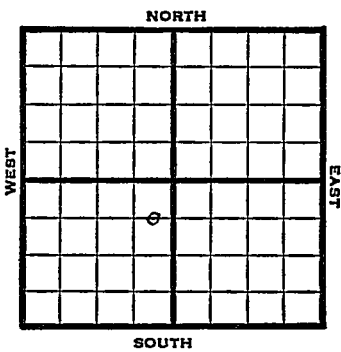

C E L NE SW

1950 Elev 1767' REPORT

3/29 Spud 3-23-50
8" @ 211'
Drlg. 2071'

4/26 TD 3310'
8" @ 211
Heebner 2805'
Br Lime 2911'
Lans 2932'
BKC 3210'
Arb. 3285'
5" @ 3309'
21/3283-90 wtr.
Set plug 3230
24/3128-3208 NS
Set Plug 3040
24/3004-12 NS
3000 A
Comp 36 bopd in Lans.
Comp

COMPLETED

Kansas

Heinz Pool

Map No. _____ Sec. 8 Twp. 18 R. 10WWell No. 3 Heinz

_____ Stagg Drlg. _____ Company

_____ Contractor

C E L NE SW


SECTION PLAT

660 Ft. from N. Line

_____ Ft. from S. Line

330 Ft. from E. Line

_____ Ft. from W. Line

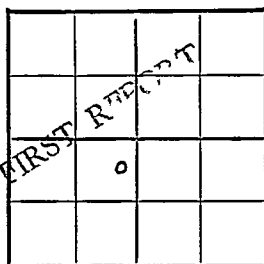

Rice County

Location _____

Rig up _____

Drilling and Remarks:

Spud 3-23-50

8" @ 211

drlg. 2071

RECORD

Cased _____ in., _____ ft.

Sand _____

Gas _____

Oil _____

Total Depth _____

PRODUCTION

1st 24 hrs. Nat. _____

1st 24 hrs. after shot _____

Gas _____ Cu. Ft.

Dry Hole _____

Abandoned _____

Date

MAR 29 1950 19J. E. TYRA

Scout

Map No. _____ Sec. 8 Twp. 18 R. 10WWell No. 3 Heinz

_____ Staggs Drlg. _____ Company

Contractor

C E L N E S W

E. 1767
SECTION PLAT660 Ft. from N. Line

_____ Ft. from S. Line

330 Ft. from E. Line

_____ Ft. from W. Line

	0		

Rice County

Location _____

Rig up _____

Drilling and Remarks:

8" C 211
 Heubner 2805
 Br line 2911
 Kans. 2932
 BKC 3210
 Arb 3285
 5" C 3309

RECORD

Cased _____ in., _____ ft.

Sand _____

Gas _____

Oil _____

Total Depth 3310

PRODUCTION

1st 24 hrs. Nat. _____

1st 24 hrs. after shot _____

Gas _____ Cu. Ft. 4000

Dry Hole _____

Abandoned _____

Date

APR 26 1950 19

J. E. TYRA Scout

21/ 3283 - 90
 Set plug 3230
 24/ 3228 - 3208
 Set plug 3000
 24/ 3004 - 1200
 3000 A

Misc. 3000
 Pierce Map
 France Map
 Tracings
 Land Wall Map
 Land Small Map
 Scout Cards
water
AS
AS

MAX 321000

Comp. 30 bupd. in Lane

RECORD
