


Section 8 Township 18 Range 10W

Well No. #4 Habiger "A"

Company Atlantic

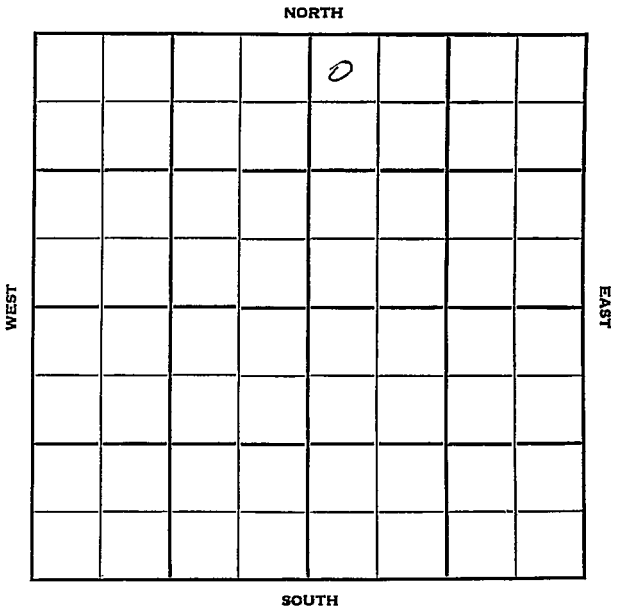

Rice KANSAS

Sec. 8 Twp. 18 R. 10 W ✓

Well No. # 4 Habiger "A" Farm

Atlantic Company

Holm Drlg. Contractor

Bloomer Pool


330 Ft. from N. Line

_____ Ft. from S. Line

_____ Ft. from E. Line

330 Ft. from W. Line

NW NW NE

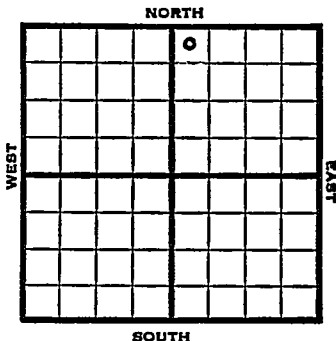

1951

Elev. 1769' REPORT

3/14

Location

4/4

Spud 3-19-51 D & A TD 3280'
 8" @ 248 Heeb 2793' Br. line 2908'
 Lans. 2926' Cong. 3224' Arb. 3274-
 80' TD D & A

ABANDONED

County Rice State Kans25

Sec. 8 (Blk. 18 (Sur. 10W Map No. 18 (Rge. 10W Map No. 18)

Operator Atlantic

Well No. 4 Farm Habiger "A"

Elev. 1769 Location NW NW NE

			6		

330 Ft. From N Line NE

330 Ft. From W Line Quarter

1st. Report

Completion APR 4 1951

Remarks Bloomer Pool

Holm Drlg. - Contr.

Spudding Date 3-19-51

Drlg. Data D & A TD 3280

8" @ 248 Heeb. 2793 Br. lime 2908

Lans. 2926 Cong. 3224 Arb. 3274-80 TD

D & A