KANSAS


FORM 51 5M 10-41 PETROL

Rice

Section 9 Township 18 Range 10-W

Well No. #1 Appel

Company I. W. Murfin et al

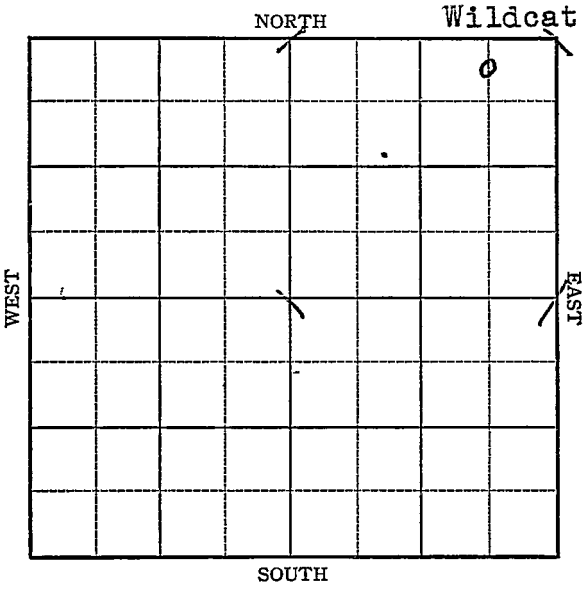

FORM 252-A
5M 10-41 PETROL

KANSAS Rice

Sec. 9 Twp. 18 R. 10-W

Well No. #1 Appel Farm

I. W. Murfin et al Company


(Wildcat)

330 Ft. from N. Line

_____ Ft. from S. Line

660 Ft. from E. Line

_____ Ft. from W. Line

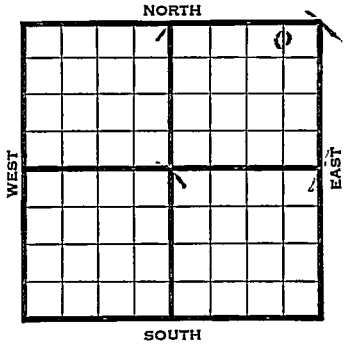

Elev. 1772

1942	REPORT
3/18	Cable.
3/26	Not cable rig.
	Rotary surface hole.
4/2	8" - 155' Anhy. 495' Drlg. 1370'
4/8	Drlg. 2400'
4/15	Lans. 2928' Cong. 3228' T.D. 3237'
	SD repairs.
4/22	Arb. 3257'
	T.D. 3275'
	No shows.
	ABANDONED

Form 26 200 Bks. 5-41 McW. Rice KANSAS

Map No. S-S- Sec. 9 Twp. 18 R. 10W

Well No. 1 Appel

I. W. Murfin etal. Company

FIRST REPORT Contractor

C NL NE NE

330 Ft. from N. Line


Ft. from S. Line

660 Ft. from E. Line

Ft. from W. Line

WILDCAT

SECTION PLAT

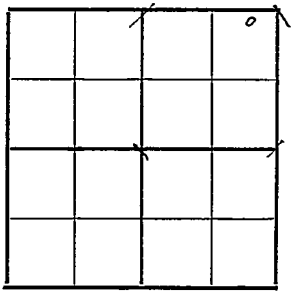

Location

Rig up

Drilling and Remarks:

Cable

RECORD

Cased in., ft.

Sand

Gas

Oil

Total Depth

PRODUCTION

1st 24 hrs. Nat.

1st 24 hrs. after shot

Gas Cu. Ft.

Dry Hole

Abandoned

Date

MAR 1 8 1942 19 S. J. LEWIS Scout

Form 26 200 Bks. 5-41 McW. Rice KANSAS

Map No. 55 Sec. 9 Twp. 18 R. 10W

Well No. 1 Appel

I. W. Murfin ETAL. Company

ABANDONED Contractor

C NL NE NE


330 Ft. from N. Line

____ Ft. from S. Line

660 Ft. from E. Line

____ Ft. from W. Line

SECTION PLAT

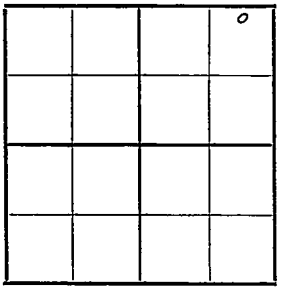

WILDCAT

Location ____

Rig up ____

Drilling and Remarks:

Ck # 3257

Nochaus

RECORD

Cased ____ in., ____ ft.

Sand ____

Gas ____

Oil ____

Total Depth 3275

PRODUCTION

1st 24 hrs. Nat. ____

1st 24 hrs. after shot ____

Gas ____ Cu. Ft.

Dry Hole ____

Abandoned ____

Date

APR 22 1942 19 S. J. LEWIS Scout