


Map No. KANSAS Sec. 9 Twp. 18 R. Rice 10^W
 Well No. 1- Blakey Farm Company
Allison & Fitzwilliams

NORTH

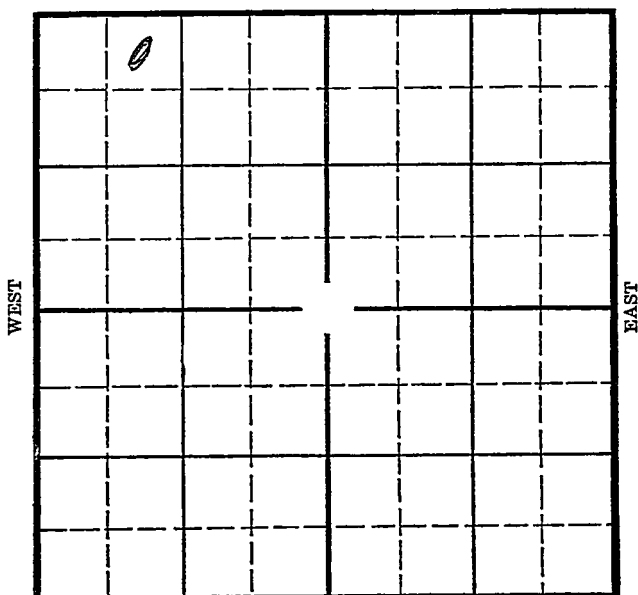

SOUTH

Location _____

Drilling Remarks _____

Rig Up _____

Drilling Remarks _____

RECORD

Cased _____ in. _____ ft.

Sand _____

Gas _____

Oil _____

Total Depth _____

PRODUCTION

1st 24 hrs. Nat. _____

1st 24 hrs. after shot _____

Gas _____ cu. ft. _____

Dry Hole _____

Abandoned _____

Map No. KANSAS Sec. 9 Twp. 18 R. 10W
Well No. 1- Blake Farm
Allison & Fitzwilliams Company


330 Ft. from N. Line

_____ Ft. from S. Line

_____ Ft. from E. Line

990 Ft. from W. Line

Elevation 1774

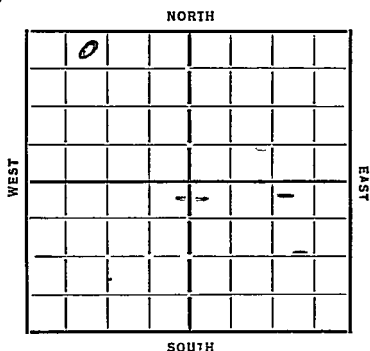

REPORT	
11/20	Material
11/29	BR
12/6	Rig
12/13	Spoke 50
12/19	20" 73 15" 236
12/26	delg 540 Top Anby 500
12/30	" 1530 12" 918
12/36	— 12" 921
1/10	delg 2625 10" 1865
1/17	SD 2925 8" 2916
1/24	Cementing Celler
1/31	Top Sand 2930
2/7	T Lib 3257 6" 3241 WOC
2/14	6" 3259
2/21	T Lib 3257 - Corrected
2/28	pipe collapsed SD.
3/7	delg ahead
3/14	6" 3259 WOC
3/21	so 3262-63
3/28	delg 3275 sho wtr

(OVER)

Map No. 55 Sec. 9 Twp. 18 R. 10 WWell No. 1 BlakeOllison & Fitzwilliams Company

Contractor

SECTION PLAT

330 Ft. from N. Line

Ft. from S. Line

Ft. from E. Line

990 Ft. from W. Line

0			

ABANDONED

Location

Rig up

Drilling and Remarks:

Granite 3520Water DisposalJ & J

RECORD

Cased _____ in., _____ ft.

Sand _____

Gas _____

Oil _____

Total Depth 3605

PRODUCTION

1st 24 hrs. Nat. _____

1st 24 hrs. after shot _____

Gas _____ Cu. Ft.

Dry Hole _____

Abandoned _____

Date

APR 19 1936

192

S. J. LEWIS

Scout

Map No. 55 Sec. 9 Twp. 18 R. 10WWell No. 1-BlakeAllison & Fritz Williams Company

Contractor

REPORTS

SECTION PLAT

0			

930 Ft. from N. Line

..... Ft. from S. Line

..... Ft. from E. Line

990 Ft. from W. Line

Location.....

Rig up.....

Drilling and Remarks:

Material

RECORD

Cased.....in.,ft.

Sand.....

Gas.....

Oil.....

Total Depth.....

PRODUCTION

1st 24 hrs. Nat.....

1st 24 hrs. after shot.....

Gas.....Cu. Ft.

Dry Hole.....

Abandoned.....

Date

11-20-35 192.....

Scout

3/6 HFW 3288-90 TN SD.

3/3 —

3/20 --

3/27--4/2-- 4/10--

4/16- Drlg. 3515'

4/23-3520' in granite.

4/29/36- Granite 3520'

T.D. 3605'

Water disposal

D.&A.

ABANDONED