


Rice

Section 10 Township 18 Range KANSAS 10W

Well No. #1 Appel "B"

Company El Reco

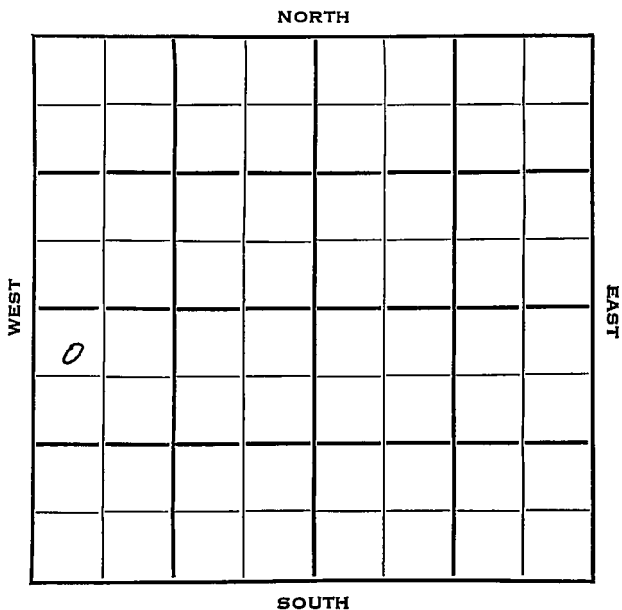

Rice

Sec. 10 Twp. 18 R. 10<sup>W</sup>

Well No. #1 Appel "B" Farm

E1 Reco Company

Group Exploration Contractor

Wildcat


330 Ft. from N. Line

\_\_\_\_\_ Ft. from S. Line

\_\_\_\_\_ Ft. from E. Line

330 Ft. from W. Line

NW NW SW

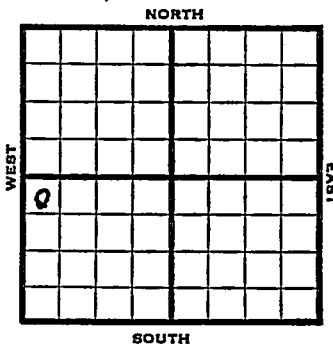

1953

Elev. 1777' REPORT

3/25

Spud 3-18-53

8" @ 198

Drlg. 2400'

4/1

Spud 3-18-53

D & A

TD 3296'

8" @ 198

Heeb 2798, Br. Lime 2915, Lans 2931,  
Cong. 3238, Arb 3256,

DST 3259-73 open  $\frac{1}{2}$  hr. Rec 5' mud  
930#

TD 3296

D & A

**ABANDONED**



