


Section **10** Township **18** Range **10W**

Well No. **#1 Shonyo**

Company **Bergman Oil**

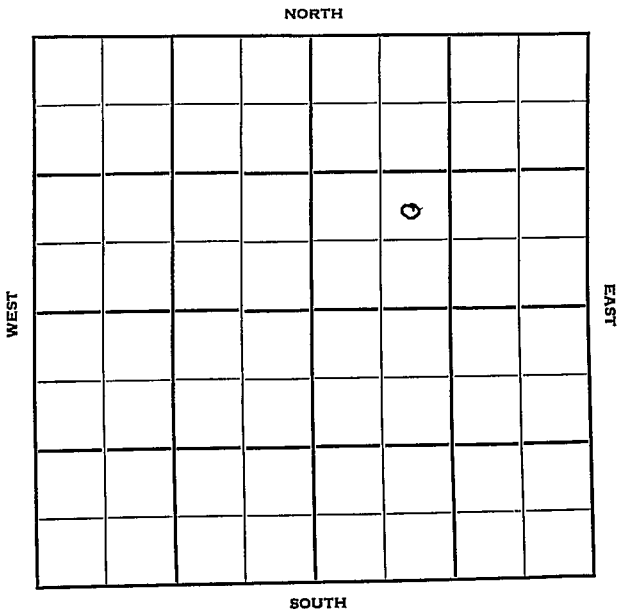

Rice

Sec. 10 Twp. 18 R. 10^W

Well No. #1 Shonyo Farm

Bergman Oil Company

Contractor

Wildcat


Ft. from N. Line

990 Ft. from S. Line

Ft. from E. Line

990 Ft. from W. Line

NE $\frac{1}{4}$ NE SW NE

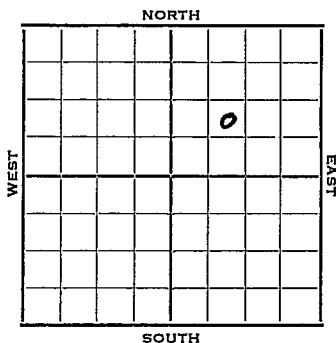

1952 Elev. 1806' REPORT

10/22 Spud 10-17-52
8" @ 185
Anhy 765'
Drlg. 1645'

10/29 D&A

11/5 Spud 10-17-52
D&A TD 3306 8" @ 185
Anhy 765 Br Li 2945 KC 2964
Cong. 3271 Arb. 3278
TD 3306' D&A

ABANDONED

