


Section 2 Township 31 Range 4E

Well No. #3 King (A)

Company Gralapp & McNish

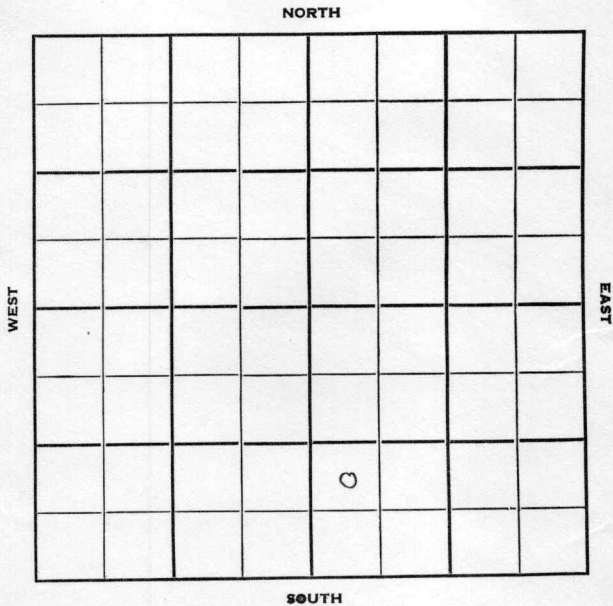

Cowley

KANSAS

Sec. 2 Twp. 31 R. LE

Well No. #3 King (A) Farm

Gralapp & McNish Company

Watson Contractor


..... Ft. from N. Line

990 Ft. from S. Line

..... Ft. from E. Line

330 Ft. from W. Line

NW SW SE

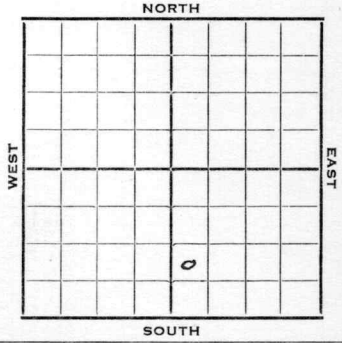

1952

Elev. 1267'

REPORT

4/2

Spud 3-27-52
8" @ 85'

Drlg. 1700'

5/7

Spud 3-27-52
Oil Well TD 2980'
8" @ 85'
Bart. 2950 TD 2980
5" @ 2958' 60 to 2980 Hydro.
Comp. 25 bopd

COMPLETED

