

KANSAS


FORM 51 5M 6-46 PETROL

Ellis county

Section 31 Township 13 Range 16-W

Well No. #1, Arnold

Company John Lindas

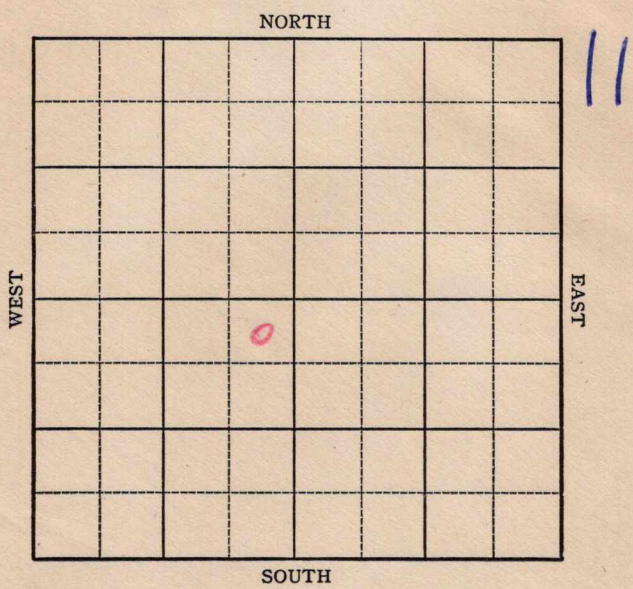

KANSAS

Ellis ✓

Sec. 31 Twp. 13 R. 16W

Well No. 1 Arnold Farm

John Lindas Company


Herzog

330 Ft. from N. Line

_____ Ft. from S. Line

330 Ft. from E. Line

_____ Ft. from W. Line

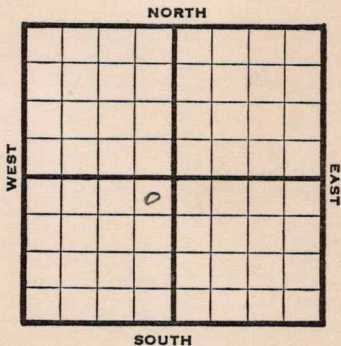

NE SW

1946

Elev. 1979' REPORT

- 11/20 RUR
- 11/27 8" @ 1062'
Anhy 1114'
Drlg 1119'
- 12/3 Drlg 3075'
- 12/10 **Lans 3246'**
3475 fsg
- 12/18 **Arb 3528'**
TD 3563'

ABANDONED

