


Cowley. KANSAS

DX 78-1

Section 2 Township 31 Range 1E

Well No. 5 King "A"

Company McNeish & Gralapp

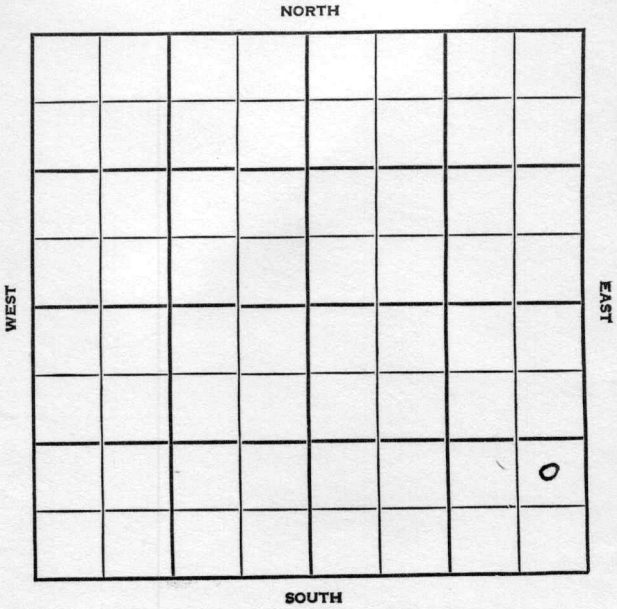

Cowley KANSAS

SEC. 2	TWP. 31	R. 4E ✓
-----------	------------	------------

WELL NO. 5 King "A" FARM

COMPANY McNish & Gralapp

CONTRACTOR Watson Drlg.


NW David Pool

_____ Ft. from N. Line

990 _____ Ft. from S. Line

330 _____ Ft. from E. Line

_____ Ft. from W. Line

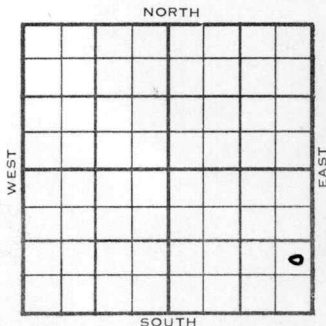

NE SE SE

1954	ELEVATION 1327	REPORT
------	-------------------	--------

6/15
7/14

Loc.
Spdg 6-19054
Oil well
TD 2997
8" @ 90
Stal 1957 KC 2374 Peru 2630 Oswego-
2740 Bart. 2973
TD 2997
5" @ 2972 CO to 2995 PB 2992 frac
Comp. 25 bopd

COMPLETED

