


Butler

Map No. Sec. 28 Twp. 27 R. 6

Well No. 1 Shriver Farm

Derby Oil Co. Company

NORTH

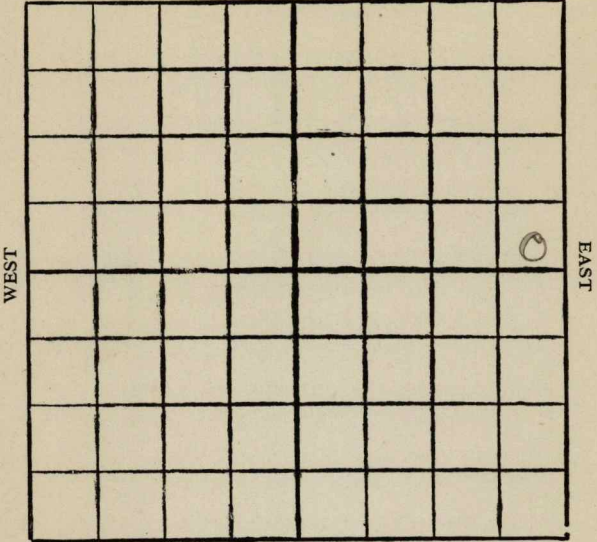

SOUTH

Location

Rig Up

Drilling Remarks

Drilling Remarks

.....

.....

RECORD

PRODUCTION

Cased in. ft.

Sand

Gas

Oil

Total Depth

1st 24 hrs. Nat.

1st 24 hrs. after shot

Gas cu. ft.

Dry Hole

Abandoned

Butler

Map No. _____ Sec. 28 Twp. 27 R. 6

Well No. 1-Skriver Farm


Derby Oil Company

_____ Ft. from N. Line

330 Ft. from S. Line

330 Ft. from E. Line

_____ Ft. from W. Line

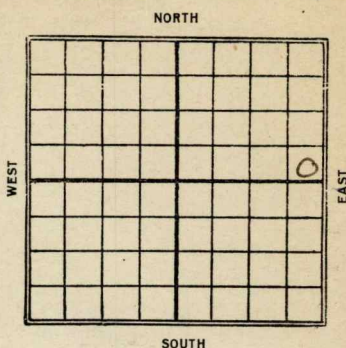

1927

Date	REPORT
6/8	Rig up
6/15	Rigging up
6/22	Rigged up + S.D.
6/29	Setting 10" - 1610
7/7	Drlg 2200
7/13	" 3660
7/20	Top line 2756 - Show oil Drlg 2850.
7/28	Base line 3005 - Sand 3075- to 3080 - Show oil -
8/3	3076 - 3080
	Top line 2756 - 3005 T.D. 3080
	25 bbls

11 **KANSAS** *Butter*
Map No. _____ Sec. *28* Twp. *27* R. *6*

Well No. *1* *Shriver*
_____ *Jerby oil Co* Company

_____ Contractor

FIRST REPORTS

SECTION PLAT

_____ Ft. from N. Line

330 Ft. from S. Line

330 Ft. from E. Line

_____ Ft. from W. Line

			o

Location _____

Rig up _____

Drilling and Remarks:

RECORD

Cased _____ in., _____ ft.

Sand _____

Gas _____

Oil _____

Total Depth _____

PRODUCTION

1st 24 hrs. Nat. _____

1st 24 hrs. after shot _____

Gas _____ Cu. Ft.

Dry Hole _____

Abandoned _____

Date _____

CHAS. L. SHERWOOD

JUN 8 1917

192

Scout

Butter

Map No. **KANSAS** Sec. *28* Twp. *27* R. *6*

Well No. *1* *Shower*
Ducky Oil Co Company

Contractor

COMPLETED

SECTION PLAT

			o

----- Ft. from N. Line

330

----- Ft. from S. Line

330

----- Ft. from E. Line

----- Ft. from W. Line

RECORD

Location -----

Cased *2* in., ----- ft.

Rig up -----

Sand *3076-3080*

Drilling and Remarks:

Gas -----

Top line 2986-3005

Oil -----

Total Depth *3080*

PRODUCTION

25 Abs.

1st 24 hrs. Nat. -----

1st 24 hrs. after shot -----

Gas ----- Cu. Ft.

Dry Hole -----

Abandoned -----

Date

AUG 3 1927

CHAS. L. SHERWOOD

192

Scout