



Rice

KANSAS

SEC. 12	TWP. 18	R. 10W
------------	------------	-----------

WELL NO.

#1 Bredfelt

FARM

COMPANY

Iron Drlg.

CONTRACTOR

Co. Tools

WILDCAT


\_\_\_\_\_ Ft. from N. Line

\_\_\_\_\_ Ft. from S. Line

\_\_\_\_\_ Ft. from E. Line

\_\_\_\_\_ Ft. from W. Line

NE NW NE

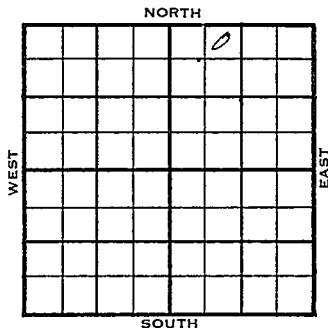

1956

ELEVATION

1750'

REPORT

3-21

Comm. 3-17-56  
8" @ 203/150  
Drlg. 1317  
Anh. 455'

5-25

DST 3246-55 op 2 hrs. rec. 90' oil,  
150' ocm, 840/20"  
5½" @ 3250  
CO to 3255  
S/ 1 boph, 48 hrs., 250A, 500 A.  
S/ 2½ boph, 14 hrs.,  
P/ 2 boph,  
P/ 64 bopd,  
Comp. 68 bopd, 20% wtr.  
Tp. 2496', H. 2762', BL. 2878',  
# L. 2896', C. 3215', A. 3245'.  
TD 3255'

COMPLETED

County Rice Elev. LOW  
 Sec. 12 Twp. 18 Rgs. LOW  
 Company Aron Drlg.  
 Farm Name Bredfelt No. 1

TOPS	DEPTH	LOG	DATUM	Loc. in Sec.
Anh.	<u>455</u>			<u>NE NW NE</u>
Tp.				
H.				
Tr.				
Dg.				
Bl.				
L.				Geol.
K.C.				Contr.
B.K.C.				<u>Co. tools</u>
Ce.				Pool
C.				<u>Wildcat</u>
M.				
M.				
K.				
Mz.				
Me.				
V.				
S.				
S.				
A.				
R.				
Pe.				FIRST REPORT
G.				
T.D.				

Date Comm. 3-17-56  
8" @ 203/150 drlg. 1317

*[Handwritten signature and scribbles]*

Co.

Lse.

No.

Sec.

T.

R.

County Rice Elev. 1750  
 Sec. 12 Twp. 18 Rge. 10W  
 Company Iron Drlg.  
 FarmName Bredfelt No. 1

TOPS	DEPTH	LOG	DATUM	Loc. in Sec.
Anb.	<u>455</u>			<u>NE NW NE</u>
TP.	<u>2496</u>			
H.	<u>2762</u>			
Tr.				
Dg.				
Bl.	<u>2878</u>		<u>1128</u>	
L.	<u>2896</u>		<u>1146</u>	Geol.
K.C.				Contr.
B.K.C.				
Ce.				
C.	<u>3215</u>		<u>1465</u>	<u>Co. tools</u>
M.				
M.				Pool
K.				
Mz.				
Mq.				
V.				
S.				
S.				
A.	<u>3245</u>		<u>1495</u>	<div style="border: 1px solid black; padding: 5px; display: inline-block;">           COMPLETE         </div>
R.				
PE.				
G.				
T.D.	<u>3255</u>			

Date Comm. 3-17-56 MAY 23 1956

8" @ 203/150 DST 3246-55 open 2 hr.

rec. 90' oil 150' ocm 840/20"

5 1/2" @ 3250 C<sup>0</sup> to 3255 S/ 1 boph

48 hr. 250 A 500 A S/ 2 1/2 boph

7 1/2 hr. P/ 2 boph P/ 64 bopd

Comp. 68 bopd 20% wtr.