KANSAS
Form 51—5M—7-39—Palace


Rice

Section 12 Township 18 Range 10-W

Well No. #1 Otto Habiger

Company Sacco

Semi-Wildcat

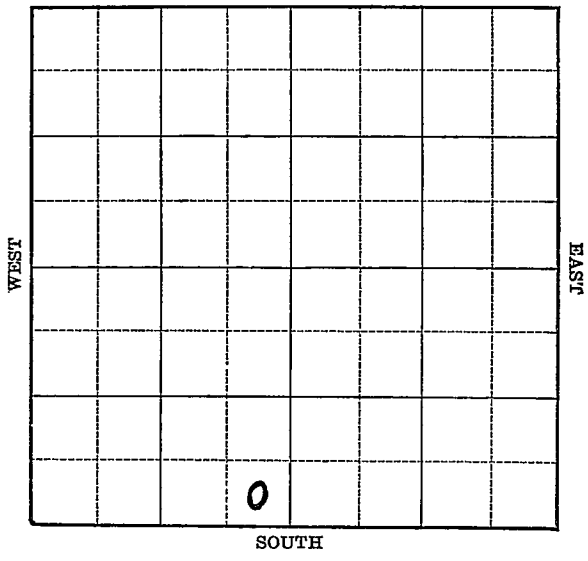

FORM 252-A 5M 4-39 KANSAS Rice

Sec. 12 Twp. 18 R. 10-W

Well No. #1 Otto Habiger Farm

Sacco Company


(Semi-Wildcat)

____ Ft. from N. Line

330 Ft. from S. Line

330 Ft. from E. Line

____ Ft. from W. Line

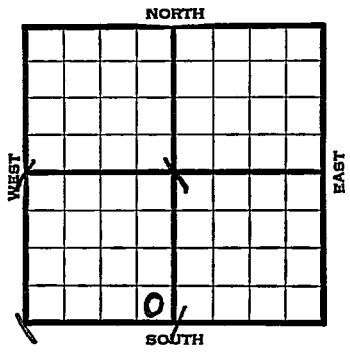

Elev. 1737

1939	REPORT
9/6	Location
9/14	Machine.
9/21	Rigging up.
9/28	15" - 90' SD.
10/5	" " "
10/12	" " "
10/19	15" - 190' Anhy 425'
	12" - 426' Drlg. 438'
10/26	Drlg. 1435'
11/2	1810' run 10".
11/9	Ft. Riley 1383' 10" - 1823'
	Drlg. 2140'
11/16	Topeka 2494' Drlg. 2695'
11/23	8" - 2740' Lans. 2905'
	Fsg. 2960'
11/29	T.D. 3105' SD.
12/7	7" - 3182' Arb. 3249'
	92' of 5" liner 3235'
	T.D. 3265½' 10 BO per hour.
12/14	T.D. 3268' Swab 75 oil & 5
	water in 4 hours.

OVER

Form 26—1M Bks.—2-29

KANSAS

Rice

Map No. 55 Sec. 12 Twp. 18 R. 10W

Well No. 1 Otto Habiger

Sacco Company

Contractor

FIRST REPORT

SE SW

Ft. from N. Line


330 Ft. from S. Line

330 Ft. from E. Line

Ft. from W. Line

SEMI-WILDCAT

SECTION PLAT

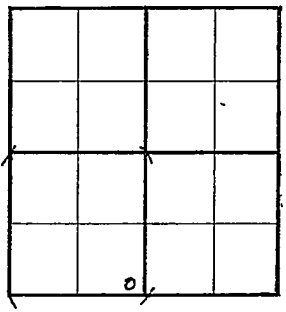

Location X

Rig up

Drilling and Remarks:

RECORD

Cased in., ft.

Sand

Gas

Oil

Total Depth

PRODUCTION

1st 24 hrs. Nat.

1st 24 hrs. after shot

Gas Cu. Ft.

Dry Hole

Abandoned

Date

SEP 6 1939 19

S. J. LEWIS Scout

Form 26—1M Bks.—2-29 Rice KANSAS

Map No. 53 Sec. 12 Twp. 18 R. 10W

Well No. 1 Otto Habiger

Saco Oil Company

Contractor

COMPLETED

SE SW

Ft. from N. Line


330 Ft. from S. Line

330 Ft. from E. Line

Ft. from W. Line

SEMI-WILDCAT

SECTION PLAT

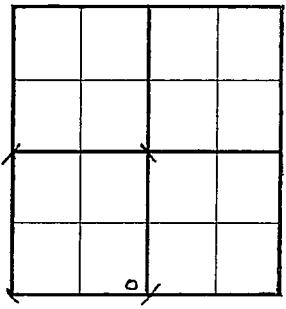

Location

Rig up

Drilling and Remarks:

Ark 3249

7" @ 3182

5" liner 3235.

Pump 373 oil

plus 14% Water.

RECORD

Cased in., ft.

Sand

Gas

Oil

Total Depth 3268.

PRODUCTION

1st 24 hrs. Nat.

1st 24 hrs. after shot

Gas Cu. Ft.

Dry Hole

Abandoned

Date

19 S. [illegible] Scout

1939

12/21 TD 3268'
Swab 75 oil & 5 water 4 hours.

12/28 " " " "

1940

1/3 Arb. 3249'
7" - 3182'
5" liner 3235'
T.D. 3268'
Pump 373 oil, plus 14% water.

COMPLETED