

Section 2 Township 31 Range 4 E

Well No. # 2 King "B"

Company McNish & Gralapp

NORTH

			0				

WEST

EAST

SOUTH

Sec. 2 Twp. 31 R. 4 E

Well No. # 2 King "B" Farm

McNish & Gralapp Company

Contractor

David Pool


330 Ft. from N. Line

Ft. from S. Line

330 Ft. from E. Line

Ft. from W. Line

NE NE NW

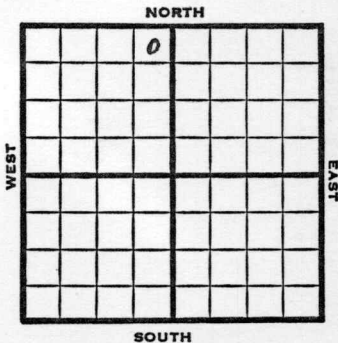

1951 Elev. 1275' REPORT

12/12 Location

1952
2/6

KC 2331
Drlg. 2683

2/13

Miss 2982' TD 2986'
5" @ 2949'

2/20

Spud 1-27-52
Oil Well T^u 2986'
8" @ 86 KC 2331 Miss. 2982
TD 2986 5" @ 2949 Hydro
Comp. 25 bopd

COMPLETED

County **Cowley** State **KAN**

Sec. **2** (Blk.) **31** (Sur.) **4E** Map No.

Operator **McNish & Gralapp**

Well No. **2** Farm **King "B"**

Elev. Location **NE NE NW**

FIRST REPORT

330 Ft. From **N** Line **NW**

330 Ft. From **E** Line **Quarter**

1st. Report **DEC 1 2 1951**

Completion

Remarks

Spudding Date

Drlg. Data **David Pool**

Location

J. E. TYRA

County Cowley State Kansas

Sec. 2 (Blk. 31 (Sur. 4E (Twp.) 31 (Rge.) 4E Map No.

Operator McNish & Gralopp

Well No. 2 Farm King "B"

Elev. 1275 Location NE NE NW

			0			

COMPLETE

330 Ft. From N Line NW

330 Ft. From E Line Quarter

1st. Report

Completion FEB 20 1952

Remarks David Pool

Spudding Date 1-27-52

Drlg. Data Oil well TD 2986

8" @ 86 KC 2331 Miss. 2982 TD 2986

5" @ 2949 Hydro. Comp. 25 bopd

J. G. McGEHEE