
KANSAS
FORM 51 5M PETROL

Barton

Section 10 Township 18 Range 14W

Well No. #3 Harper

Company Texas

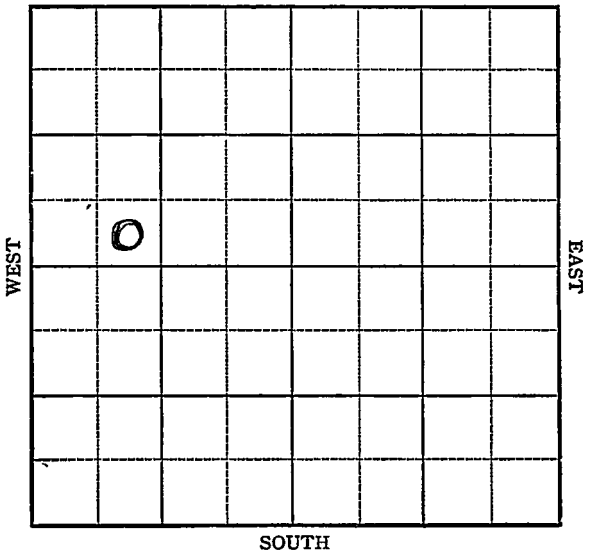

FORM 252-A
5M'3-44 KANSAS

Barton

Sec. 10 Twp. 18 R. 14W

Well No. #3 Harper Farm

Texas Company


Boyd

_____ Ft. from N. Line

330 Ft. from S. Line

_____ Ft. from E. Line

990 Ft. from W. Line

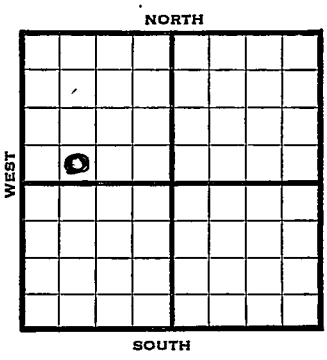

Elev. 1953

1944	REPORT
3/29	Location
4/5	Drlg. 655
4/12	8" @ 916 Drlg. 1900
4/19	Drlg. 3046
4/26	Lans 3204 SO, 3277-98 Arb ~~3434-52 TD~~ 3431 - 3449 T.D. 5" @ 3433 Rust
5/3	"
5/10	Swb 140 oil in 10 hrs
5/17	Arbuckle 3431 5" - 3430 Pot. Pump 195 Gravity 38. Total Depth 3449

COMPLETED

Form 26 200 Bks 5-42 Petrol

Barton

KANSAS

Map No. 73 Sec. 10 Twp. 18 R. 14W


Well No. 3 Harper

Texas Company

FIRST REPORT Contractor

SE SW NW

SECTION PLAT

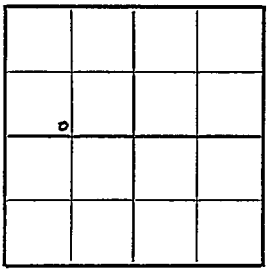

____ Ft. from N. Line

330 Ft. from S. Line

____ Ft. from E. Line

990 Ft. from W. Line

Boyd Pool

Location X

Rig up

Drilling and Remarks:

RECORD

Cased ____ in., ____ ft.

Sand

Gas

Oil

Total Depth

PRODUCTION

1st 24 hrs. Nat.

1st 24 hrs. after shot

Gas ____ ¢ Cu. Ft.

Dry Hole

Abandoned

Date

MAR 29 1944 19

S. J. LEWIS Scout

FORM 26 200 BKS 2-44 PETROL

KANSAS Pool Name Boyd

Map No. 73 Sec. 10 Twp. 18 R. 14W


Well No. 3 Harper

Texas Company

COMPLETED Contractor

SE SW NW

SECTION PLAT

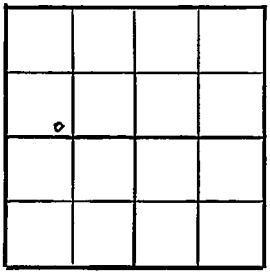

____ Ft. from N. Line

330 Ft. from S. Line

____ Ft. from E. Line

990 Ft. from W. Line

Barton County

Location

Rig up

Drilling and Remarks:

Cr 3431
5' @ 3438

Pump. 195 BO

38 - Gr

RECORD

Cased ____ in., ____ ft.

Sand

Gas

Oil

Total Depth 3447

PRODUCTION

1st 24 hrs. Nat.

1st 24 hrs. after shot

Gas ____ Cu. Ft.

Dry Hole

Abandoned

Date

MAY 17 1944 19 S. J. LEWIS Scout