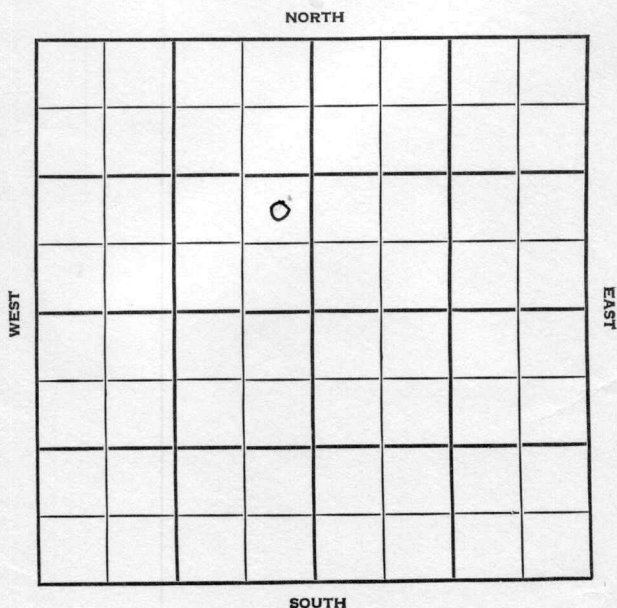


Section 2 Township 31 Range 4 EWell No. #10 King "B"Company McNeish & Gralapp

Cowley

KANSAS

SEC.	2	TWP.	31	R.	4E
------	---	------	----	----	----

WELL NO.

#10 King "B"

FARM

COMPANY

McNeish & Gralapp

CONTRACTOR

Watson


David

Ft. from N. Line

Ft. from S. Line

Ft. from E. Line

Ft. from W. Line

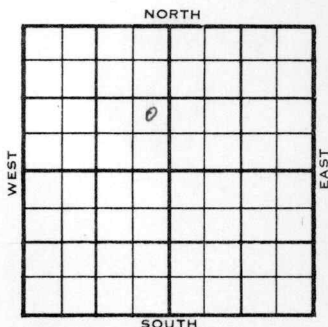

NE SE NW

1955	ELEVATION	REPORT
------	-----------	--------

1254

8/24

Comm 8-19-55

8" @ 85/90

Drog 2200

9/7

Comm 8-19-55

KC 2308

BKC Bart 2926

8" @ 85/90

5 1/2" @ 2926 CO to 2950

frac Comp 25 bopd

COMPLETED

County

Conley

Elev.

Sec.

2

Twp.

31

Rge.

1E

Company

McNeish & Gralapp

FarmName

King "B"

No.

10

TOPS

DEPTH

LOG

DATUM

Loc. in Sec.

Anh.

Tp.

H.

Tr.

Dg.

B.L.

L.

K.C.

B.K.C.

Ce.

C.

M.

M.

K.

Mz.

Mq.

V.

S.

S.

A.

R.

Pc.

G.

T.D.

NE SE NW

Geol.

Contr.

Watson

Pool

David

	8	
AUG 24 1955		
FIRST REPORT		

Date Comm.

8-19-55

8" @ 85/90

drlg. 2200

County Cowley Elev. 1254
 Sec. 2 Twp. 31 Rge. 4E
 Company McNeish & Gralapp
 Farm Name King "B" No. 10

TOPS	DEPTH	LOG	DATUM
Anh.			
TP.			
H.			
Tr.			
Dg.			
BL.			
L.			
K.C.	<u>2308</u>		<u>1054</u>
B.K.C. <u>Bank</u>	<u>2926</u>		<u>1072</u>
Ce.			
C.			
M.			
M.			
K.			
Mz.			
Mq.			
V.			
S.			
S.			
A.			
R.			
PE.			
G.			
T.D.	<u>2950</u>		

Loc. in Sec. _____

NE SE NW

Geol. _____

Contr. _____

Watson

Pool _____

David

Date Comm. 8-19-55

SEP 7 1955

8" @ 85/90

5 $\frac{1}{2}$ " @ 2926

CO to 2950

frac Comp. 25 bopd