


Section 28 Township 27 Range 6E

Well No. 9 Stern (*Stearn*)

Company Cromwell & Lewis

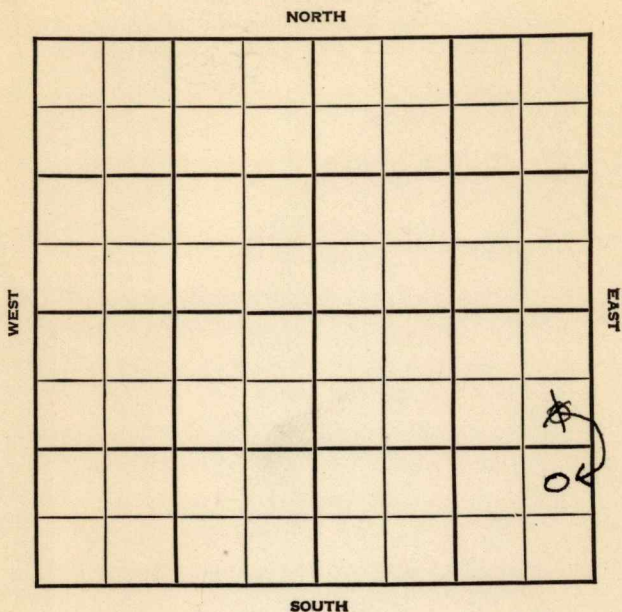



Sec. 28 Twp. 27 R. 6E

Well No. #9 Stern Farm

Cromwell & Lewis Company


Misc.

~~990~~ Ft. from N. Line

990 Ft. from S. Line

330 Ft. from E. Line

_____ Ft. from W. Line

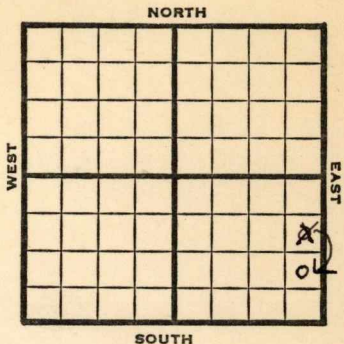

~~SE NE SE~~ NE SE SE

1948	Elev. 1375' REPORT
4/28	Drlg. 985'
5/4	12" @ 988' Drlg. 1615'
5/12	10" @ 2055' KC 2075' Drlg. 2230'
5/19	Mississippi 2711' Run 8"
5/26	Miss 2711' 7" @ 3046' Viola 3065' Pump 75 Pot. oil Gr. 38° TD 3075'
COMPLETED	

Map No. _____ Sec. 28 Twp. 27 R. 6E

Well No. 9 Stern

Cromwell & Lewis Company

FIRST REPORT

Contractor

SE NE SE

SECTION PLAT

990 Ft. from N. Line

_____ Ft. from S. Line

330 Ft. from E. Line

_____ Ft. from W. Line

			o

Butler County

Location _____

Rig up _____

Drilling and Remarks:

drlg. 985

RECORD

Cased _____ in., _____ ft.

Sand _____

Gas _____

Oil _____

Total Depth _____

PRODUCTION

1st 24 hrs. Nat. _____

1st 24 hrs. after shot _____

Gas _____ Cu. Ft.

Dry Hole _____

Abandoned _____

Date

APR 28 1948

19

S. J. LEWIS

Scout

Map No. 11 Sec. 28 Twp. 27 R. 6E

Well No. 9 Stern

Cromwell & Lewis Company

COMPLETE

Contractor

NE SE SE

E1, 1375
SECTION PLAT

			o

_____ Ft. from N. Line

990 Ft. from S. Line

330 Ft. from E. Line

_____ Ft. from W. Line

Butler County

Location _____

Rig up _____

Drilling and Remarks:

Miss 2711
7C3046
Vista 3065

Pump 250 ft
oil

352 ft.

RECORD

Cased _____ in., _____ ft.

Sand _____

Gas _____

Oil

Total Depth 3025

PRODUCTION

1st 24 hrs. Nat. _____

1st 24 hrs. after shot _____

Gas _____ Cu. Ft.

Dry Hole _____

Abandoned _____

Date

MAY 26 1948

S. J. LEWIS Scout