


Section 28 Township 27 Range 6E

Well No. #1 Stern

Company Cromwell & Elphick

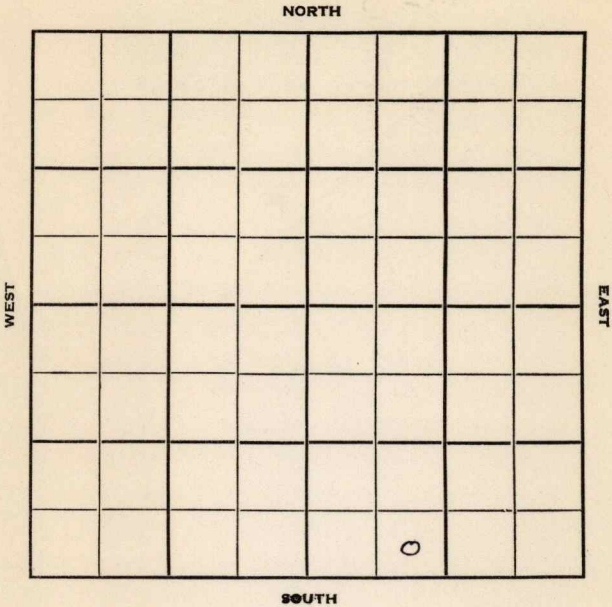

Butler

KANSAS

Sec. 28 Twp. 27 R. 6E

Well No. #1 Stern Farm

Cromwell & Elphick Company

Murfin Drlg. Contractor

Leon Pool


 Ft. from N. Line

330 Ft. from S. Line

 Ft. from E. Line

990 Ft. from W. Line

SE SW SE

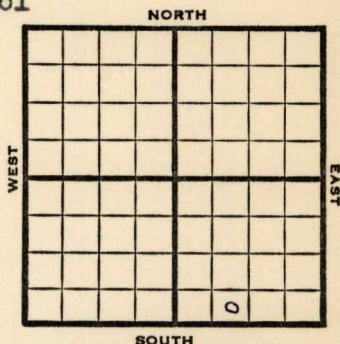

1951

Elev. 1382'

REPORT

12/5 Location

1952

1/30

Spud 12-7-51

Oil Well TD 3079

13" @ 850

10" @ 1845

KC 2090

BKC 2280

Miss 2723

8" @ 2735

2½" goph Viola 3069

5" 3064 TD 3079

1000 A Comp. 15 bopd

COMPLETED

Kansas

28

Cromwell & Elphick

1

SE SW SE

FIRST REPORT

330

990

DEC 5 1951

Completion

Remarks

Murfin Drlg. - Contr.

Spudding Date

Leon Pool

Location

County Butler State Kansas

Sec. 28 (Blk. Twp.) 27 (Sur. Rge.) 6E Map No.

Operator **Cromwell & Elphick**

Well No. 1 Farm Stern

Elev.	1382	Location	SE SW SE
-------	------	----------	----------

COMPLETE

0

330 Ft. From S Line SE

990 Ft. From W Line Quarter

1st. Report

Completion JAN 30 1952

Remarks	Leon Pool
---------	-----------

Murfin Drlg. - Contr.

Spudding Date 12-7-51

Drilg. Data Oil well TD 3079

13" @ 850 10" @ 1845 KC 2090

B KC 2280 Miss. 2723 8" @ 2735

2 $\frac{1}{2}$ goph Viola 3069 5" @ 3064

TD 3079 1000 A Comp. 15 bopd

J. G. McGEHEE