

Section 2 Township 31 Range 4 E

Well No. # 4 King "B"

Company McNeish & Gralapp

NORTH

		0					

WEST

EAST

SOUTH

Cowley KANSAS



Sec. 2 Twp. 31 R. 4 E

Well No. # 4 King "B" Farm

McNeish & Gralapp Company

Watson Contractor


David Pool

990 Ft. from N. Line

_____ Ft. from S. Line

990 Ft. from E. Line

_____ Ft. from W. Line

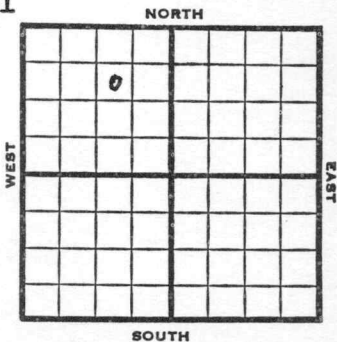

SW NE NW

1953

Elev. 1271' REPORT

8/5 8" @ 86

9/30 Oil Well
 TD 2943'
 8" @ 86'
 Bart 2917'
 TD 2943'
 5" @ 2919'
 CO to 2943'
 sd-frac
 Comp 25 bopd.

COMPLETED

County Cowley State Kansas

Sec. 2 (Blk.) 31 (Sur. Rge.) 4E Map No.

Operator McNeish & Gralapp

Well No. 4 Farm King "B"

Elev. Location SW NE NW

	0				

990 Ft. From N Line NW

990 Ft. From E Line Quarter

1st. Report AUG 5 1953

Completion _____

Remarks _____

Watson - Contr.

Spudding Date _____

Drlg. Data David Pool

8" @ 86

County Cowley State Kansas

Sec. 2 (Blk. 31 (Sur. 4E Map No. (Twp.) (Rge.))

Operator McNeish & Gralapp

Well No. 4 Farm King "B"

Elev. 1271 Location SW NE NW

	0				

990Ft. From N Line NW

990Ft. From E Line Quarter

1st. Report

Completion SEP 30 1953

Remarks David Pool

Watson - Contr.

Spudding Date

Drlg. Data Oil well TD 2943

8" @ 86 Bart. 2917 TD 2943 5" @ 2919

CO to 2943 sd-frac Comp. 25 bopd