


Section 31 Township 13 Range 16-W

Well No. #1 Brumgardt

Company Gulf

NORTH Miscellaneous

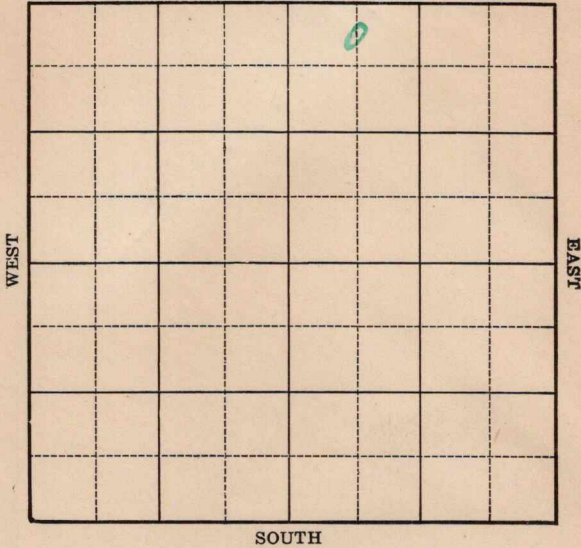

Sec. 31 Twp. 13 R. 16-W

Well No. #1 Brumgardt Farm

Gulf Company

(Misc.)


330 Ft. from N. Line

_____ Ft. from S. Line

_____ Ft. from E. Line

660 Ft. from W. Line

Elev. 1967

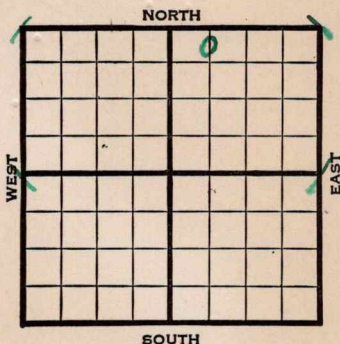

1940	REPORT
10/30	8" - 185'
	Drlg. 2370'
11/7	B.K.C. 3470' Arb. 3473-74½' Dlg.
11/14	5" - 3474' T.D. 3481'
	125' oil 12 hours.
11/21	T.D. 3492' Swab 23 bbls. in 3 hours. 2000 acid. Swab 118 bbls. 4 hours.
11/27	" "
12/5	Potential 457 bbls., pump. Shut down.
12/12	" "
12/19	P.B. to 3476'
12/26	" " "
1941	
1/2	" " "
1/9	On potential.
1/16	" "
	OVER

741045

2807

1941
1/22

Arb. 3473'

5" - 3474'

T.D. 3492'

3000 acid.

Echometer potential 1259 bbls.

Gravity 37.8

COMPLETED

Map No. 71 Sec. 31 Twp. 13 R. 16W

Well No. 1 Brumgardt

Gulf Company

Contractor

FIRST REPORT

C N L NW NE

330 Ft. from N. Line

_____ Ft. from S. Line

_____ Ft. from E. Line

660 Ft. from W. Line

SECTION PLAT

MISCELLANEOUS

Location _____

Rig up _____

Drilling and Remarks:

8" - 185

Drlg. 2370

RECORD

Cased _____ in., _____ ft.

Sand _____

Gas _____

Oil _____

Total Depth _____

PRODUCTION

1st 24 hrs. Nat. _____

1st 24 hrs. after shot _____

Gas _____ Cu. Ft.

Dry Hole _____

Abandoned _____

Date

OCT 30 1944

S. J. LEWIS Scout

Map No. 71 Sec. 31 Twp. 13 R. 16W

Well No. 1 Brumgardt

Gulf Company

Contractor

COMPLETED

SECTION PLAT

		o	

C N L NW NE

330 Ft. from N. Line

_____ Ft. from S. Line

_____ Ft. from E. Line

660 Ft. from W. Line

MISCELLANEOUS

Location _____

Rig up _____

Drilling and Remarks:

Ar 73473
5" C 3474
3000 acid
Ech rd P 81259
Gr. 37.8

RECORD

Cased _____ in., _____ ft.

Sand _____

Gas _____

Oil _____

Total Depth 3492

PRODUCTION

1st 24 hrs. Nat. _____

1st 24 hrs. after shot _____

Gas _____ Cu. Ft.

Dry Hole _____

Abandoned _____

Date

JAN 22 1941 19

S. J. LEWIS

Scout