

Butler

KANSAS


Form 51—5M—11-38—Palace

Section 28 Township 27 Range 6-E

Well No. 1 Tabing

Company Landon & Allison

Stearn Pool

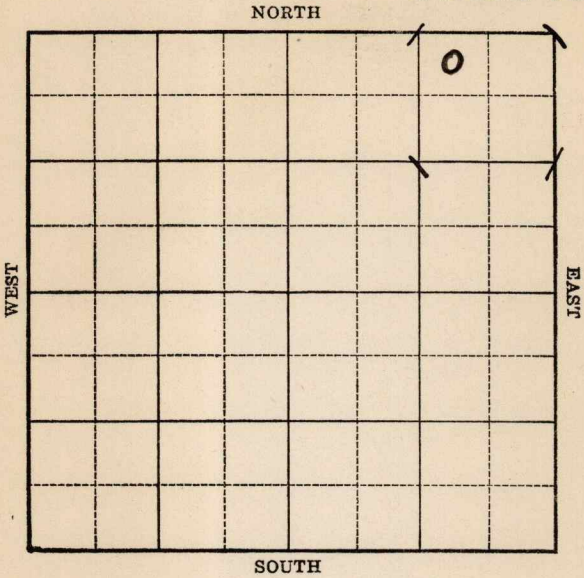

KANSAS

Butler

Sec. 28 Twp. 27 R. 6-EWell No. #1 Tabing FarmLandon & Allison

Company


(Stearn)

330 Ft. from N. Line

Ft. from S. Line

990 Ft. from E. Line

Ft. from W. Line

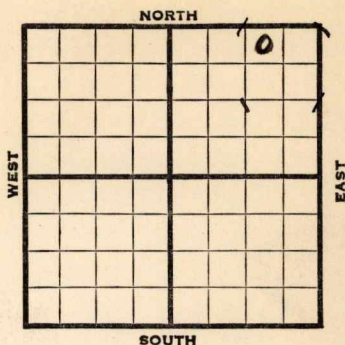**Elev. 1372'****1939**

REPORT

4/5

R.U. Machine.

4/14

Spud.

4/21

15" - 270' 12" - 990'

Drlg. 1085'

4/28

10" - 1779' T.D. 1865'

SD repairs.

5/5

Lans. 2085' Drlg. 2460'

5/12

Miss. Lime & 8" - 2726'

3 B.W. 2865 to 2870'

Drlg. 2820'

5/19

Viola 3074' 6" - 3076'**Pay 3076 to 3085' WOC.**

5/24

Viola 3074'

6" - 3076'

T.D. 3084'

1000 acid.

Pump 50 bbls.

COMPLETED

Butler

KANSAS

Map No. // Sec. 28 Twp. 27 R. 6EWell No. 1 TabingLandon & Allison

Company

Contractor

FIRST REPORT

NW NE NE

330 Ft. from N. Line Ft. from S. Line990 Ft. from E. Line Ft. from W. Line

STEARN POOL

SECTION PLAT

			0

Location Rig up

Drilling and Remarks:

RU Mach

RECORD

Cased in., ft.Sand Gas Oil Total Depth

PRODUCTION

1st 24 hrs. Nat. 1st 24 hrs. after shot Gas Cu. Ft.Dry Hole Abandoned

Date

APR 5 - 1939 19H. D. Hatfield

Scout

Butler

KANSAS

Map No. 11 Sec. 28 Twp. 27 R. 6EWell No. 1 TabingLandon & Allison

Company

Contractor

COMPLETED

SECTION PLAT

NW NE NE

330 Ft. from N. Line Ft. from S. Line990 Ft. from E. Line Ft. from W. Line

STEARN POOL

			0

Location Rig up

Drilling and Remarks:

*Viola 2074**6" @ 3076**1000 acid**Pump 50 87 1/2*

RECORD

Cased in., ft.Sand Gas Oil Total Depth 3084

PRODUCTION

1st 24 hrs. Nat. 1st 24 hrs. after shot Gas Cu. Ft.Dry Hole Abandoned

Date

MAY 24 1939

19

S. J. LEWIS Scout