


DX 78-1

1

Section 10 Township 18 Range 14W

Well No. 1 Hlavoty

Company Derby Oil

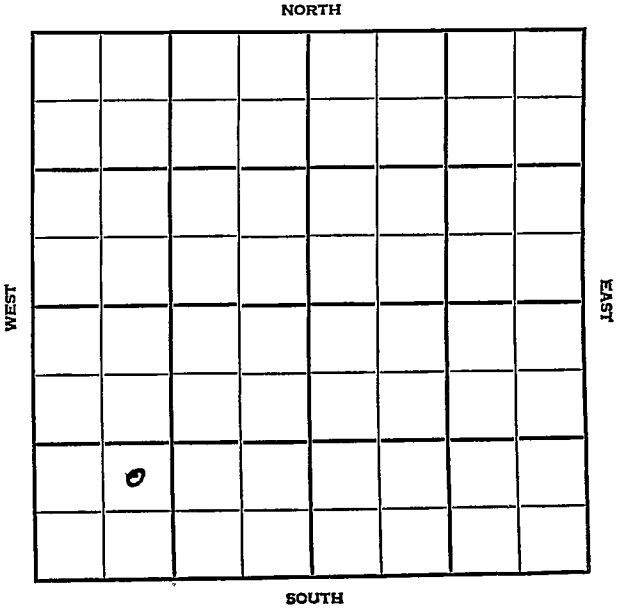

Barton KANSAS

SEC.	TWP.	R.
10	18	14W ✓

WELL NO.

1 Hlavoty

FARM

COMPANY

Derby Oil

CONTRACTOR

Rocket Drlg.-Contr.


Wildcat

_____ Ft. from N. Line

990 _____ Ft. from S. Line

_____ Ft. from E. Line

990 _____ Ft. from W. Line

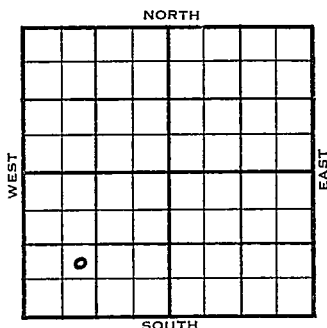

NE SW SW

	ELEVATION	REPORT
1954	1936'	

6/15 Spdg. 6-11-54
8" @ 910

WOC

6/23 Spud 6-11-54 D & A TD 3450
8" @ 910 Anhy 895 Lans 3186

DST 3200-10 open 1 hr rec 45' mud
325#

DST 3264-72 open 1 hr rec 40' WCM
880# Cong. 3401' Arb. 3428

DST 3429-34 open 1 hr rec 50' mud 0#

DST 3436-44 open 1 hr rec 5' mud
1080#

DST 3436-50 open 1 hr rec 180' wtr.

925# TD 3450' D & A

ABANDONED

County Barton State Kansas

Sec. **10** (Blk. **18** (Sur. **14W** Map No.

Operator **Derby Oil**

Well No. **1** Farm **Elavoty**

Elev.	Location	NE	SW	SW
-------	----------	----	----	----

990 Ft. From S Line SW

990 Ft. From ~~W~~ Line Quarter

1st. Report **JUN 15 1954**

Completion

Remarks "

Rocket Drlg. - Contr.


Spudding Date **6-11-54**

Drig. Data **Wildcat**

8" @ 910 F06

J. G. McGEHEE

County Barton State Kansas
 Sec. 10 (Blk. 18) (Sur. 14W) Map No.
 Operator Derby Oil
 Well No. 1 Farm Hlavoty
 Elev. 1936 Location NE SW SW

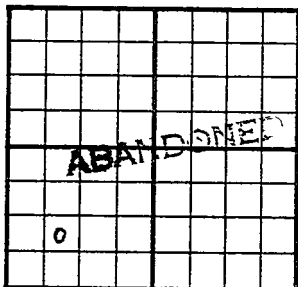

990 Ft. From S Line SW
 990 Ft. From W Line Quarter
 Ist. Report
 Completion JUN 23 1954
 Remarks Wildcat
Rocket Drlg. - Contr.
 Spudding Date 6-11-54

Drlg. Data D & A TD 3450
8" @ 910 Anhy 895 Lans. 3186
DST 3200-10 open 1 hr. Rec. 45' mud
325# DST 3264-72 open 1 hr. Rec. 40'
wcm 880# Cong. 3401 Arb. 3428
DST 3429-34 open 1 hr. Rec. 50' mud
0# DST 3436-44 open 1 hr. Rec. 5' mud
1080# DST 3436-50 open 1 hr. Rec.
180' wtr. 925# TD 3450

D & A

J. G. McGEHEE