

# KANSAS


Barton

FORM 51 5M 1-42 PETROL

Section 11 Township 18 Range 14-W

Well No. #2 Eveleigh

Company Cities Service Oil

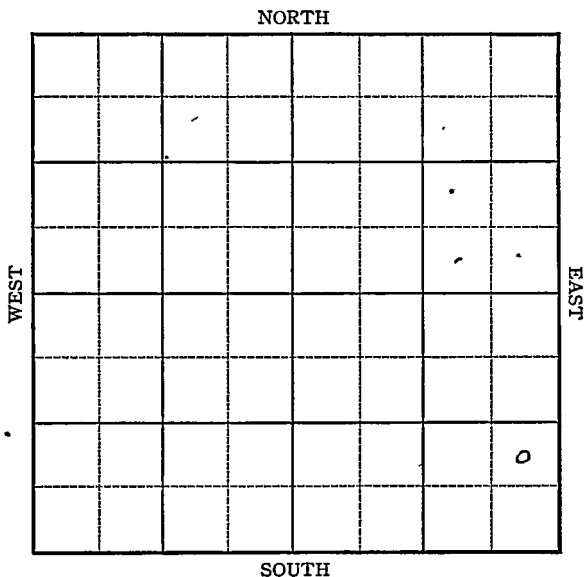


KANSAS

Barton

Sec. 11 Twp. 18 R. 14-W

Well No. #2 Eveleigh Farm  
Cities Service Oil Company

NORTH

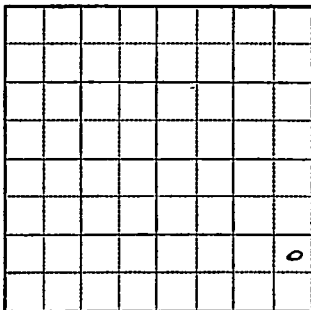

\_\_\_\_\_ Ft. from N. Line

970 Ft. from S. Line

330 Ft. from E. Line

\_\_\_\_\_ Ft. from W. Line

*Elev. 1861*

R E P O R T

1948

- 1/5 Rotary
- 1-12 Drlg 400'
- 1/19 Drlg. 1990'
- 1/26 Lans 3116
- Ceng 3339
- Arb 3409
- TD 3441

**ABANDONED**

KANSAS

Map No. 73 Sec. 11 Twp. 18 R. 14W

Well No. 2 Eveleigh

Cities Service Oil Company

FIRST REPORT Contractor

NE SE SE

SECTION PLAT

\_\_\_\_\_ Ft. from N. Line

970 Ft. from S. Line

330 Ft. from E. Line

\_\_\_\_\_ Ft. from W. Line

			0

BOYD POOL

Location \_\_\_\_\_

Rig up \_\_\_\_\_

Drilling and Remarks:

Rotary

RECORD

Cased \_\_\_\_\_ in., \_\_\_\_\_ ft.

Sand \_\_\_\_\_

Gas \_\_\_\_\_

Oil \_\_\_\_\_

Total Depth \_\_\_\_\_

PRODUCTION

1st 24 hrs. Nat. \_\_\_\_\_

1st 24 hrs. after shot \_\_\_\_\_

Gas \_\_\_\_\_ Cu. Ft.

Dry Hole \_\_\_\_\_

Abandoned \_\_\_\_\_

Date

JAN 5 1944 19

S. J. LEWIS Scout

**KANSAS**  
 Map No. 3 Sec. 11 Twp. 18 R. 14W

Well No. 2 Eveleigh

Cities Service Oil Company

ABANDONED Contractor

NE SE SE

SECTION PLAT

\_\_\_\_\_ Ft. from N. Line

970 Ft. from S. Line

330 Ft. from E. Line

\_\_\_\_\_ Ft. from W. Line

			o

Boyd Pool

Location \_\_\_\_\_

Rig up \_\_\_\_\_

Drilling and Remarks:

*Leas 3116.  
 Cong 3339  
 3409*

RECORD

Cased \_\_\_\_\_ in., \_\_\_\_\_ ft.

Sand \_\_\_\_\_

Gas \_\_\_\_\_

Oil \_\_\_\_\_

Total Depth 3441

PRODUCTION

1st 24 hrs. Nat. \_\_\_\_\_

1st 24 hrs. after shot \_\_\_\_\_

Gas \_\_\_\_\_ Cu. Ft.

Dry Hole \_\_\_\_\_

Abandoned \_\_\_\_\_

Date

JAN 26 1944 19

S. J. LEWIS Scout