


Section 11 Township 18 Range 11W

Well No. #2 Eveleigh "A"

Company Lewis Drlg.

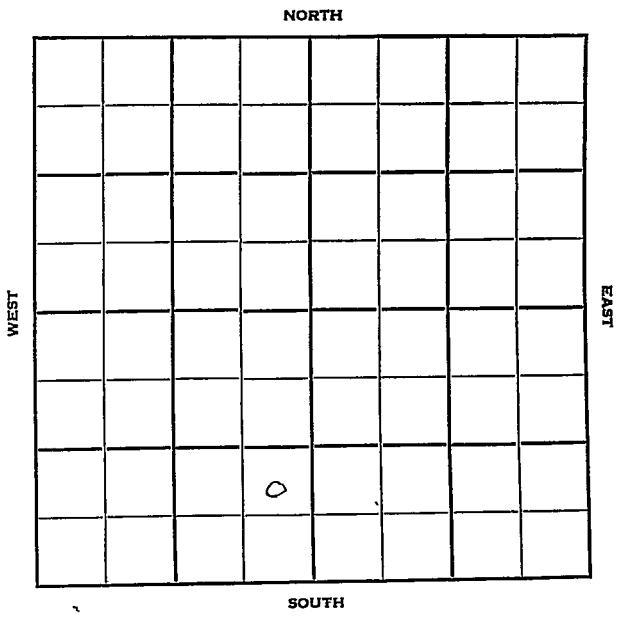

Barton

KANSAS

Sec. 11 Twp. 18 R. 14W ✓

Well No. #2 Eveleigh "A" Farm

Lewis Drlg. Company

Contractor

Eveleigh Pool


Ft. from N. Line

990' Ft. from S. Line

330' Ft. from E. Line

Ft. from W. Line

NE SE SW

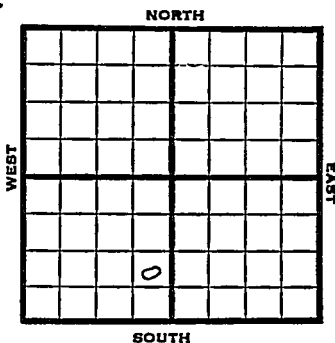

1951

Elev. 1924' REPORT

8/29

Spud 8-25-51
8" @ 145
Anhy 875
Drlg. 930'

9/19

Spud 8-25-51
D & A TD 3428' 8" @ 145
Anhy 875' Heeb 3095' KC 3172'
Cong. 3386'
DST 3368-98 open 1 hr. rec 240' mud
961' SW Arb. 3421-28'
DST 3424-28 open 1 hr. rec 14' mud w/
SSO 5" @ 3423 TD 3428'
500 A HFW D & A

ABANDONED

