
FORM 51 25M 3-49 PETROL

KANSAS
Barton

Section 11 Township 18 Range 14W

Well No. #1 Miller "A"

Company Lewis Drlg. etal

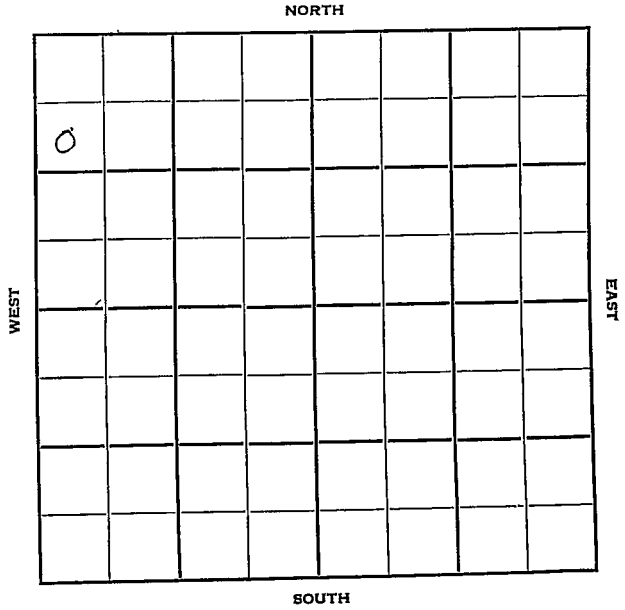

FORM 252-A
5M 10-48 PETROL

Barton KANSAS

Sec. 11 Twp. 18 R. 14W

Well No. #1 Miller "A" Farm

Lewis Drlg. et al Company

Boyd Pool (Lewis Drlg, Contr.)


990' Ft. from N. Line

Ft. from S. Line

Ft. from E. Line

330' Ft. from W. Line

SW NW NW

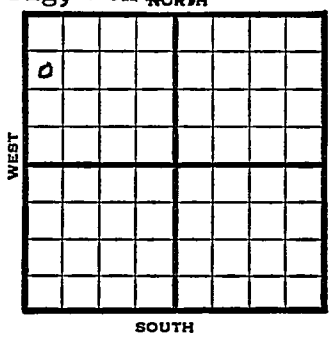

1950	Elev. 1904' REPORT
1/11	Spud 1-9-50 Drlg. 535'
1950 2/22	8" @ 854' 5" @3395' Lans 3147' Congl 3553' Arb 3393' 213 BOPD TD 3398'
	COMPLETED

Form 26 200 Bks. 6-49 Petrol

Kansas Boyd Pool

Map No. ____ Sec. 11 Twp. 18 R. 14W

Well No. 1 Miller "A"

Lewis Drlg. etal. Company

Lewis Drlg. Contractor

SW NW NW

990 Ft. from N. Line

____ Ft. from S. Line

____ Ft. from E. Line

330 Ft. from W. Line

Barton County

SECTION PLAT



Location ____

Rig up ____

Drilling and Remarks:

Spud 1-9-50

drlg. 535

RECORD

Cased ____ in., ____ ft.

Sand ____

Gas ____

Oil ____

Total Depth ____

PRODUCTION

1st 24 hrs. Nat. ____

1st 24 hrs. after shot ____

Gas ____ Cu. Ft.

Dry Hole ____

Abandoned ____

Date

JAN 11 1950 19 ____ J. E. TYRA Scout

Form 26 200 Bks. 11-49 Petrol

Kansas

Boyd Pool

Map No. _____ Sec. 11 Twp. 18 R. 14W

Well No. 1 Miller "A"


Lewis Drlg. etal.
Company

Contractor

SW NW NW

El. 1904

SECTION PLAT

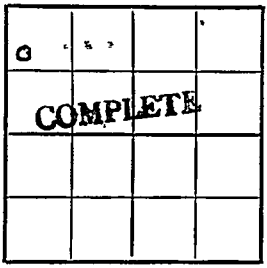

990 Ft. from N. Line

Ft. from S. Line

Ft. from E. Line

330 Ft. from W. Line

Barton County

Location

Rig up

Drilling and Remarks:

8" @ 854
5" @ 3395
Lans 3147
Corg 3553
Arb 3393
213 BOPD

RECORD

Cased in., ft.

Sand

Gas

Oil

Total Depth 3398

PRODUCTION

1st 24 hrs. Nat.

1st 24 hrs. after shot

Gas Cu. Ft.

Dry Hole

Abandoned

Date

FEB 22 1950 19

J. E. TYRA
Scout