

Section 11 Township 18 Range 14-WWell No. #3 Miller "A"Company Lewis Drlg.

NORTH

	○						

WEST

EAST

SOUTH

Barton

KANSAS

Sec. 11 Twp. 18 R. 14W

Well No. #3 Miller "A" Farm

Lewis Drlg. Company

Lewis Drlg. - Contr. Contractor

Boyd Pool


330' Ft. from N. Line

 Ft. from S. Line

 Ft. from E. Line

990' Ft. from W. Line

NE NW NW

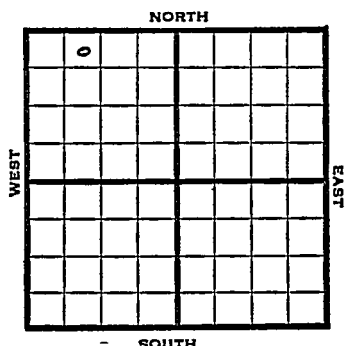

1950	Elev. 1928'	REPORT
11/15	Spud 11-13-50	
12/6	Spud 11-13-50 D&A TD 3420 8" @ 145' Anhy 875' Heeb. 3095' Lans. 3170 Cong. 3375 Arb. 3415-20 5" @ 3415 TD 3420 500 A 10 bfph 10% oil D&A ABANDONED	

County Barton State KansasSec. 11 (Blk. Twp.) 18 (Sur. Rge.) 14W Map No.Operator Lewis Drlg.Well No. 3 Farm Miller "A"Elev. Location NE NW NW

	o						

330 Ft. From N Line NW990 Ft. From W Line Quarter1st. Report NOV 15 1950

Completion

Remarks

Lewis Drlg. - Contr.Spudding Date 11-13-50Drlg. Data Boyd Pool

J. E. TYRA

County Barton State KansasSec. 11 (Blk.
Twp.) 18 (Sur.
Rge.) 14W Map No.Operator Lewis Drlg.Well No. 3 Farm Miller "A"Elev. 1928 Location NE NW NW

	o						

330 Ft. From N Line NW990 Ft. From W Line Quarter1st. ReportCompletion DEC 6 1950Remarks Boyd PoolLewis Drlg. - Contr.Spudding Date 11-13-50Drlg. Data D & A TD 34208" @ 145 Anhy 875 Heeb. 3095Lans. 3170 Cong. 3375 Arb. 3415-205" @ 3415 TD 3420 500 A 10 bfph10% soil D & A

J. E. TYRA