

Ellis

KANSAS

SECTION 31 TOWNSHIP 13 RANGE 16 W

WELL NO. #1 Brungardt

COMPANY Artnell & Linds

NORTH

							0

8

WEST

EAST

SOUTH

Ellis

KANSAS

SEC. 31	TWP. 13	R. 16W
------------	------------	-----------

WELL NO.

#1 Brungardt

FARM

COMPANY

Artnell & Lindas & Oak-Zleming

CONTRACTOR

Herzog


_____ Ft. from N. Line

_____ Ft. from S. Line

_____ Ft. from E. Line

_____ Ft. from W. Line

NE SE NE

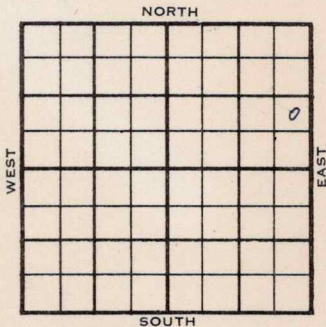

1955

ELEVATION

REPORT

12-28

Location

County Ellis Elev. _____
 Sec. 31 Twp. 13 Rge. 16W
 Company Artroll & Lindas
 Farm Name Brungardt No. 1

TOPS	DEPTH	LOG	DATUM
Anh.			
Tp.			
H.			
Tr.			
Dg.			
B.L.			
L.			
K.C.			
B.K.C.			
Ce.			
C.			
M.			
M.			
K.			
Mz.			
Mq.			
V.			
S.			
S.			
A.			
R.			
Pe.			
G.			
T.D.			

Loc. in Sec. NE SE NE

Geol. _____

Contr. _____

Pool Herzog

DEC 28 '55
 0
 FIRST REPORT

Date Comm. _____
 Location _____

(Large red handwritten mark, possibly 'A' or 'H')

Co.

Lse.

No.

Sec.

T.

R.

County Ellis Elev X1959 DF
 Sec. 31 Twp. 13 Rgn. 16W
 Company Artnell & Lindas & Oak-Fleming
 Farm Name Brungardt No. 1

TOPS	DEPTH	LOG	DATUM	Loc. in Sec.
Arb	X1080			NE SE NE
Tr.				
H.				
Tr.				
Dg.				
Bl.				
L.	3210	3212	1253	X Bob Gensch Geol.
K.C.				
B.K.C.				Cont. X Prime #2
Ce.				
C.				
M.				
M.				Pool
K.				Herzog
Mz.				
Mo.				
V.				
S.				
S.				
A.	3469	2464	1505	FEB 15 1956
R.				COMPLETE
PC.				
G.				
TA	3473			

Date Comm. Gulf FO
 Location JAN 5 '56 X12-29-55 878 @ 204
1445 @ 2910 JAN 11 '56 DST 3200
-20 1hr rec 180 @ CMSW
+60' 0 @ G54 WEG +120' oil +
180' OCW + 240' WTR BHP 270
DST 3224-38 rec 1hr g to 5"
32" rec 80' V HOC GCM +1700'
G54 oil BHP 800 DST 3254-96
1hr rec 30' OCM + 255' 0 @ GCSW

BHT 1250 DST 3464-73 1hr
rel 30' 50cm BHT 75#
5 1/2 3466 / JAN 18 '56 Co DD
3485 IB 8 60 + 14 6 WPH
LWL P19 ? 12/3245-48 8 6
Boph nolw NT2 8 36 1/2 Boph
1200' o.B. gran 410 POP
JAN 25 '56 ✓ FEB 1 '56 ✓ FEB 8 '56 P 120
Bo in 8 hrs nolw to FEB 15 '56 ✓
Ph P 296 Bopd 570 w
gran 410

R.G.

FEB 27 1956

18016L