


Section 2 Township 31 Range 4E

Well No. 6 Vivian King

Company McNeish & Gralapp

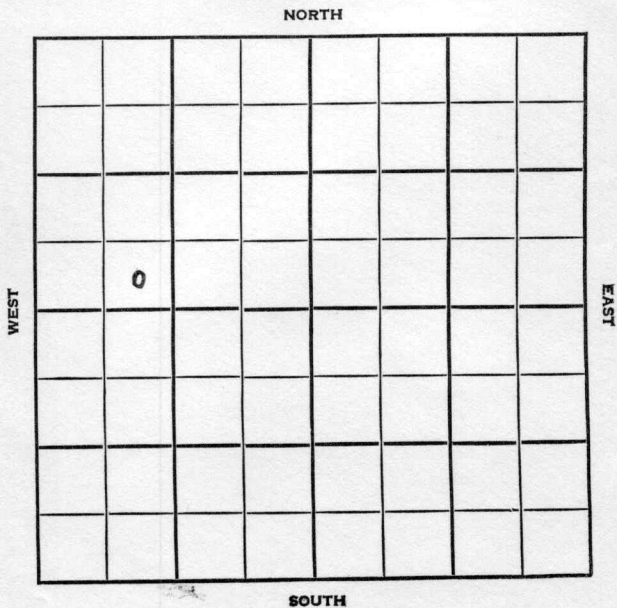

Cowley

KANSAS

SEC. 2	TWP. 31	R. 4E
------------------	-------------------	-----------------

WELL NO. _____

6 Vivian King FARM

COMPANY _____

McNeish & Gralapp


CONTRACTOR _____

_____ Ft. from N. Line

330 _____ Ft. from S. Line

_____ Ft. from E. Line

990 _____ Ft. from W. Line

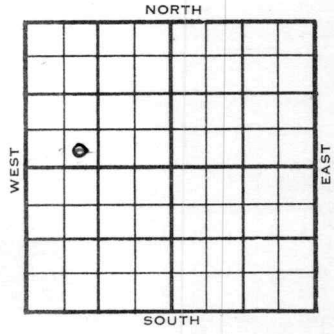

SE SW NW

	ELEVATION	REPORT
1954	1238'	

1954
6/2
6/15

M I R

Oil well TD 2940' 8" @ 85
 Bart 2910' TD 2940 5" @ 2915
 CO to 2940 PB 2920 frac.
 Comp. 150 BOPD

COMPLETED

