


Section 11 Township 18 Range 14 W

Well No. #2 Miller "C"

Company Cities Service Oil

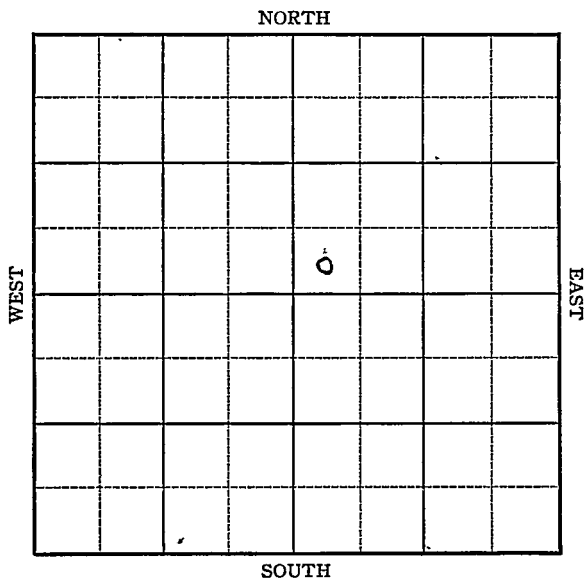

KANSAS

Barton

Sec. 11 Twp. 18 R. 14W

Well No. #2 Miller "G" Farm

Cities Service Oil Company

Boyd


NORTH

_____ Ft. from N. Line

330 Ft. from S. Line

_____ Ft. from E. Line

330 Ft. from W. Line

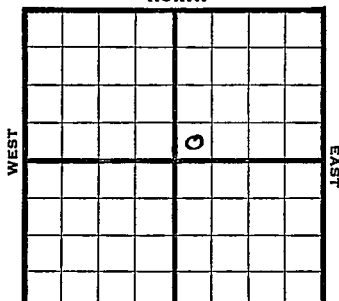

Elev. 1883

REPORT

1944

5/10 Drk.

5/17 Rotary

5/31 Arb 3398

TD 3428

ABANDONED

KANSAS

Pool Name BoydMap No. 3 Sec. 11 Twp. 18 R. 14WWell No. 2 Miller "G"Cities Service Oil CompanyFIRST REPORT Contractor

SW NE

SECTION PLAT

		o	

 Ft. from N. Line330 Ft. from S. Line Ft. from E. Line330 Ft. from W. Line

Barton County

Location Rig up

Drilling and Remarks:

Derrick

RECORD

Cased in., ft.Sand Gas Oil Total Depth

PRODUCTION

1st 24 hrs. Nat. 1st 24 hrs. after shot Gas Cu. Ft.Dry Hole Abandoned

Date

MAY 10 1944 19

S. J. LEWIS Scout

