

KANSAS


FORM 51 5M PETROL

Barton

Section 11 Township 18 Range 14W

Well No. #1 Miller "G"

Company Cities Service Oil

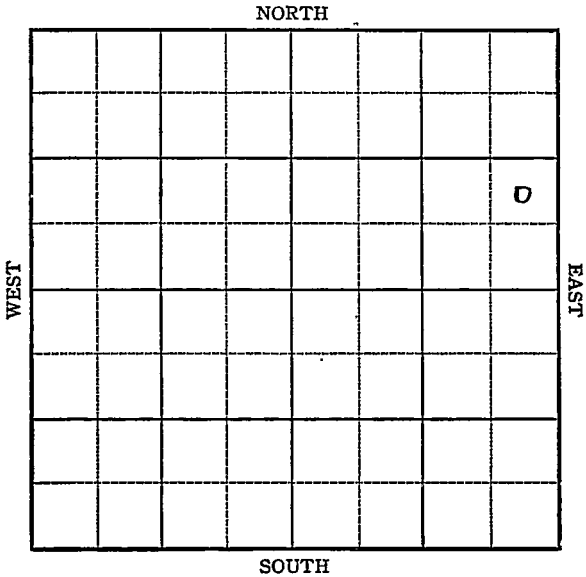

Sec. 11 Twp. 18 R. 14W

Well No. #1 Miller "G" Farm

Cities Service Oil Company


Boyd

 Ft. from N. Line

990 Ft. from S. Line

330 Ft. from E. Line

 Ft. from W. Line

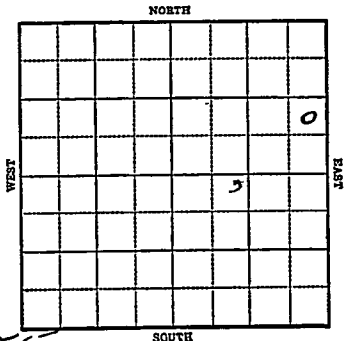

elev. 1855

R E P O R T

1944

- 2/16 Derrick
- 2/23 8" @ 754
Drlg. 822
- 3/1 Arb 3339
T^D 3341 SSO
Run Csg.
- 3/8 Lans 3098
Cong 3313
5" @ 3340
Rust
- 5/3/16 TD 3346-500 acid
Swb & fluid per hr 20% water.
- 3/22 Arb. 3339
5" @ 3340
TD 3346
500 acid
Pump 195 oil & 42 water
Pot
Gravity 39.0

COMPLETED

KANSAS
 Map No. 72 Sec. 11 Twp. 18 R. 14W

Well No. 1 Miller "G"

Cities Service Company

CORRECTION Contractor

NE SE NE

SECTION PLAT

_____ Ft. from N. Line

990 Ft. from S. Line

330 Ft. from E. Line

_____ Ft. from W. Line

Boyd Pool

Location _____

Rig up _____

Drilling and Remarks:

Changed from
 1 Miller "C"

RECORD

Cased _____ in., _____ ft.

Sand _____

Gas _____

Oil _____

Total Depth _____

PRODUCTION

1st 24 hrs. Nat. _____

1st 24 hrs. after shot _____

Gas _____ Cu. Ft.

Dry Hole _____

Abandoned _____

Date

MAR 1 1944 19

S. J. LEWIS Scout

