


Section 3 Township 31 Range 4E

Well No. 3 Watt "A"

Company H. H. Blair

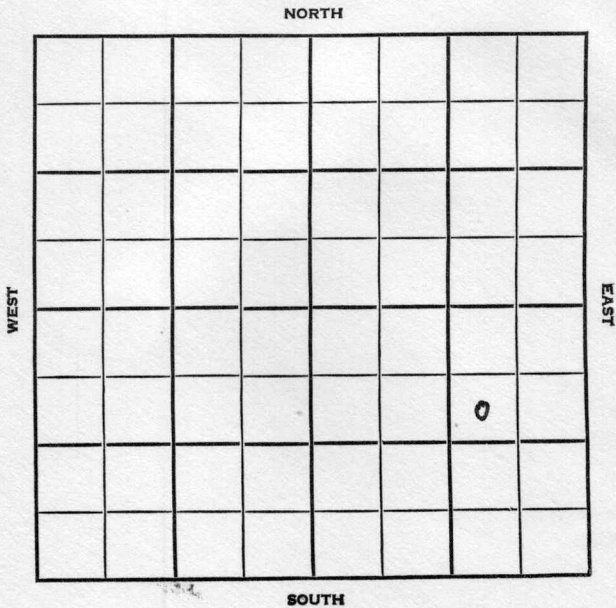

Cowley

KANSAS


SEC.	3	TWP.	31	R.	4E
------	---	------	----	----	----

WELL NO. #3 Watt "A" FARM

COMPANY H.H. Blair

CONTRACTOR Watson Drlg.
N. David Pool

990 Ft. from N. Line
 Ft. from S. Line
 990 Ft. from E. Line
 Ft. from W. Line

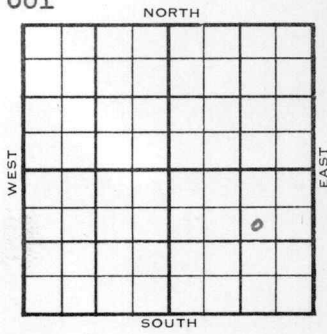

SW NE SE

1955	ELEVATION 1247'	REPORT
------	--------------------	--------

1/19 Location
 2/16 Spud 1-22-55 Oil well TD 2954
 8" @ 92 KC 2320 Bart 2926
 TD 2954
 Log Tops: Stal. 1924', KC 2320'
 Bart 2937'.
 TD 2952' 5" @ 2939 CO to 2954
 PB 2951 frac.
 Comp. 25 BOPD

COMPLETED

