


Butler

Map No. _____ Sec. 33 Twp. E 7 R. 6

Well No. 2 - Giessler Farm
Patton et al Company

NORTH

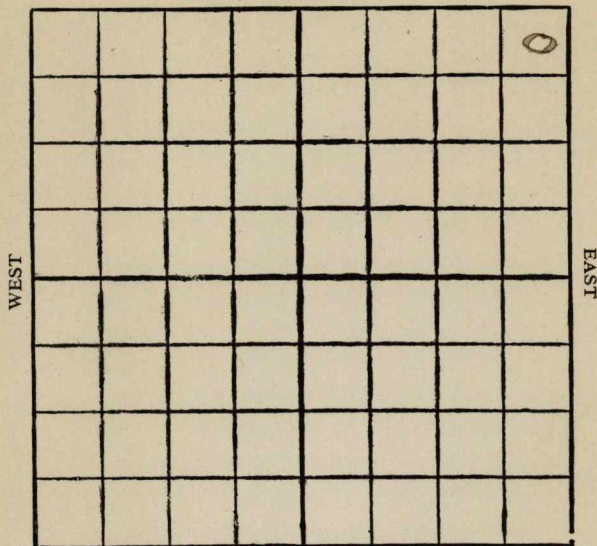

SOUTH

Location

Drilling Remarks

Rig Up.....

Drilling Remarks

RECORD

Cased.....in.ft.

Sand

Gas

Oil _____

Total Depth.....

PRODUCTION

1st 24 hrs. Nat.

1st 24 hrs. after shot.....


Gas..... cu. ft.

Dry Hole

Abandoned

Map No. _____ Sec. 33 Twp. 27 R. 6
 Well No. 2 - Giesler Farm
Patton et al Company

NORTH

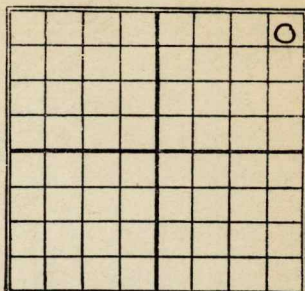

330 Ft. from N. Line

_____ Ft. from S. Line

330 Ft. from E. Line

_____ Ft. from W. Line

SOUTH

1927

Date

REPORT

6/8	Rig up
6/15	Spudding
6/22	fishing 900
6/29	Drlg 1450
7/7	" 1840
7/13	" 2300
7/20	fishing 2400
7/28	Top line 2735 - Drlg 2990-
8/3	3079-3084
	T.D. 3084
	Top line 2735-3010
	145 bbls

Butler

11 KANSAS 33 27 6
Map No. Sec. Twp. R.2 Siegel
Well No. Patton et al
Company

Contractor

FIRST REPORTS

SECTION PLAT

330 Ft. from N. Line

Ft. from S. Line

330 Ft. from E. Line

Ft. from W. Line

			0

Location ✓

Rig up

Drilling and Remarks:

RECORD

Cased _____ in., _____ ft.

Sand _____

Gas _____

Oil _____

Total Depth _____

PRODUCTION

1st 24 hrs. Nat. _____

1st 24 hrs. after shot _____

Gas _____ Cu. Ft.

Dry Hole _____

Abandoned _____

Date

JUN

8 1937

CHAS. L. SHERWOOD

192

Scout

Map No. 11 KANSAS Sec. 33 Twp. 27 R. 6

Well No. 2 Greaser

Patton et al Company

Contractor

COMPLETED

SECTION PLAT

330 Ft. from N. Line

_____ Ft. from S. Line

330 Ft. from E. Line

_____ Ft. from W. Line

			0

Location _____

Rig up _____

Drilling and Remarks:

200' line 2935-3010

RECORD

Cased 3079-3084 in., 3084 ft.

Sand _____

Gas _____

Oil _____

Total Depth 3084

PRODUCTION

1st 24 hrs. Nat. _____

1st 24 hrs. after shot _____

Gas _____ Cu. Ft.

Dry Hole _____

Abandoned _____

Date

AUG 3 1927 CHAS. L. SHERWOOD

192

Scout