


Section 32 Township 13 Range 16W

Well No. #2 Braun

Company Todd Drlg

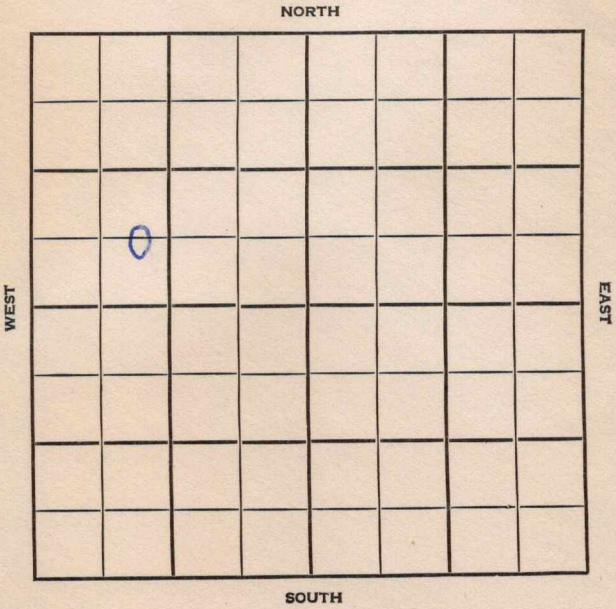

Ellis

KANSAS

SEC.

TWP.

R.

32

13

16W

WELL NO.

#2 Braun

FARM

COMPANY

ToddDrlg.

CONTRACTOR

Co. Tools


Towlon

Ft. from N. Line

Ft. from S. Line

Ft. from E. Line

Ft. from W. Line

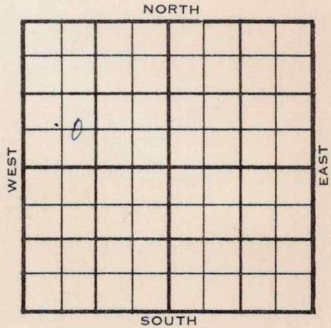C E $\frac{1}{2}$ SW NW

1956

ELEVATION

1935 RB, 1933 DF

REPORT

3-21

Comm. 3-19-56

8" @ 212/150

WOC

5-2

DST 3178-3203 op 1 hr. # 2070' gas, rec 90' gcm, 20' muddy oil, 180' oil, 3 gw, 530/20".

DST 3223-3240 op 1 hr. rec. 35' mud, 905/20"

5 $\frac{1}{2}$ " @ 3496/125

CO to 3450, 16/ 3212-16 #, 2000 A

S/ 36 boph, 2 hrs.

Comp. 422 bopd

Anh. 1055

H. 3130

L. 3181

C. 3431

A. 3490

TD 3496'

COMPLETED

County Ellis Elev. _____
 Sec. 32 Twp. 13 Rge. 16W
 Company Todd Drlg.
 Farm Name Braun No. 2

TOPS	DEPTH	LOG	DATUM	Loc. in Sec.
Anh.				<u>C E $\frac{1}{2}$ SW NW</u>
Tr.				
H.				
Tr.				
Dg.				
B.L.				
L.				Geol. _____
K.C.				Contr. _____
B.K.C.				<u>Co. tools</u>
Ce.				
C.				Pool _____
M.				<u>Towlon</u>
M.				
K.				
Mz.				
Me.				
V.				
S.				
S.				
A.				
R.				
Pe.				
G.				
T.D.				

0

FIRST REPORT

MAR 21 '56

Date Comm. 3-19-56
8" @ 212/150 WOC.

1935 RB

1933 DF

County

Ellis

Elev.

Sec.

32

Twp.

13

Rge.

16W

Company

Todd Drlg.

Farm Name

Braun

No.

2

TOPS

DEPTH

LOG

DATUM

Loc. in Sec.

Anh.

1055

Tp.

C E $\frac{1}{2}$ SW NW

H.

3130

Tr.

Dg.

B.L.

L.

3181

1248

K.C.

Geol.

B.K.C.

Ce.

Contr.

C.

3431

1498

Co. tools

M.

M.

K.

Pool

Mz.

Toulon

Mq.

V.

S.

COMPLETE

S.

A.

3490

1557

R.

P.C.

G.

T.D.

3496

Date Comm.

3-19-56

MAY

2 1956

8" @ 212/150 DST 3178-3203 open 1 hr.

2070' gas rec. 90' gcm 20' muddy oil

180' oil 3 gw 530/20" DST 3223-3240

open 1 hr. rec. 35' mud 905/20"

TD 3496 5 $\frac{1}{2}$ " @ 3496/125 CO to 3450

16/ 3212-16 2000 A S/ 36 boph 2 hr.

Comp. 422 bopd