


Section 11 Township 18 Range 14 W

Well No. # 6 Miller (G)

Company Cities Service Oil

NORTH

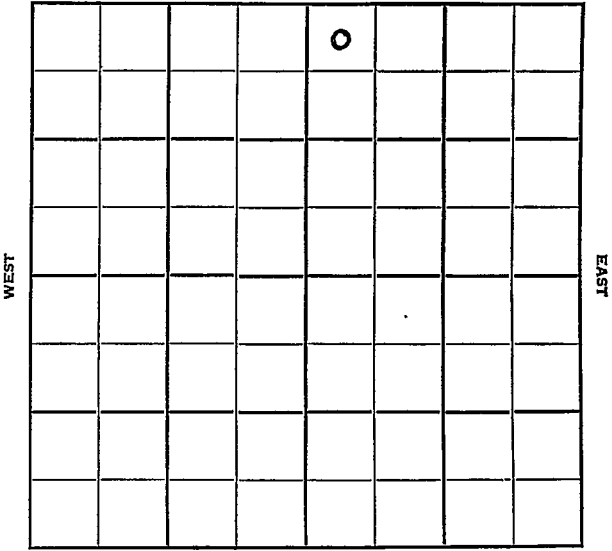

SOUTH

Sec. 11 Twp. 18 R. 14 W

Well No. # 6 Miller (G) Farm

Cities Service Oil Company

Contractor

Boyd-Pool


330 Ft. from N. Line

_____ Ft. from S. Line

_____ Ft. from E. Line

330 Ft. from W. Line

NW NW NE

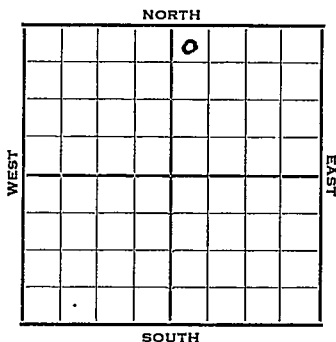

1952 Elev. 1888' REPORT

3/26 Location
4/1 8" @ 853'
Drlg. 2095'
4/9 Heeb. 3054 Lans. 3127
Cong. 3347 Ero Arb. 3352
Arb. 3357 RTD 3359
5" @ 3359
4/23 DD 3361 TD 500' oil 15 hrs.
500 A S17½ BO & 1 BW 24 hrs.
1500 A
4/30 P/ 88 BO & 20 BW 24 hrs. POP
5/7 NR
5/14 "
5/21 "
5/28 "
6/11 Spud 3-27-52
Oil Well TD 3361' 8" @ 853'
Heeb. 3054 Lans. 3127
Cong. 3347 ReArb. 3352
Arb. 3357
TD 3359 5" @ 3359 B/ mud
DD 3361 FU 500' oil 15 hr.
500 A P/ 17½ bo 1 bw 24 hr.
1500 A P/ 88 bo 20 bw 24 hr.
Comp. 123 bopd 39% wtr.

COMPLETED

O. W. P. B.

S-513-B

County Barton Elev. 1888DF
 Sec. 11 Twp. 18 Rge. 14W
 Company C. S. O.
 Farm Name Miller "G" No. 6

TOPS	DEPTH	LOG	DATUM
Anh.			
Tp.			
H.			
Tr.			
Dg.			
B.L.			
L.	3122		
K.C.			
B.K.C.			
Ce.			
C.			
M.			
M.			
K.			
Mz.			
Mq.			
V.			
S.			
S.	3352		
A.			
R.			
Pf.			
G.			
T.D.			

Loc. in Sec. NW NW NE
(O.W.P.B.)
 Geol. O. W. P. B.
 Contr. _____
 Pool _____
Eveleigh

FEB 19 1938
FIRST REPORT
ABANDONED

Date Comm. _____
OLD INFO: Tops. 5" @ 3353, OTD 3361, Arb well.
NEW INFO: PB 3230, 29/3177-84, 33/3158-66, 2000A, P 3/4 BO + 16 BW/24 D & A

Co. No. Sec. T. R.