


Section 33 Township 27 Range 6E

Well No. #1 Shriver #1 Shawver

Company Cromwell & Lewis et al (Shriver)

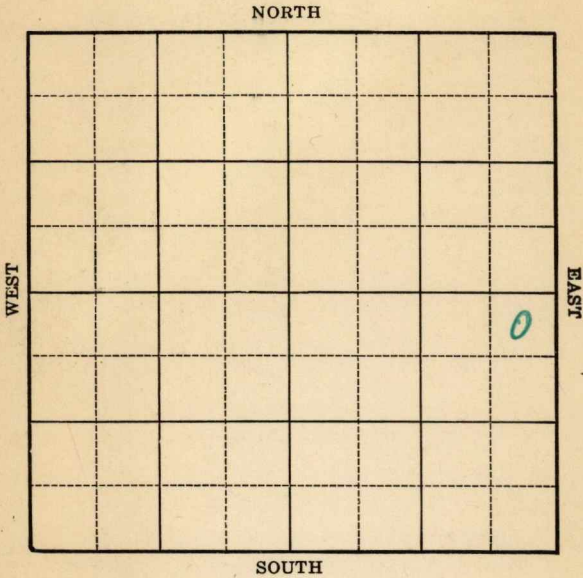

Sec. 33 Twp. 27 R. 6-E

Well No. ~~#4 Shriver~~ #1 Shawver Farm

Cromwell & Lewis et al Company

(Misc.)


330 Ft. from N. Line

\_\_\_\_\_ Ft. from S. Line

330 Ft. from E. Line

\_\_\_\_\_ Ft. from W. Line

Elev. 1402

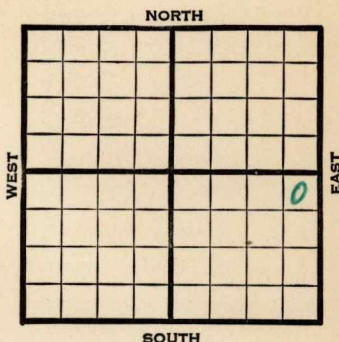

1940	REPORT
10/16	Material.
10/24	15" - 401' Drlg. 670'
10/31	12" - 1021' Drlg. 1390'
11/7	10" - 1700' Drlg. 2150'
11/14	Lans. 1785' K.C. 2103'
	SSO 2105-19' W. 2200-10'
	8" - 2325' Miss. 2740'
	6" - 2845' T.C. C.O.
11/21	B. Miss. 3018' Viola 3093'
	Pay 3093-95' T.D. 5" - 3083'
	250' oil.
11/27	" " "
12/4	Viola 3093'
	5" - 3083'
	T.D. 3095'
	500 acid.
	Pump 25 bbls.
	39.8 Gravity
	COMPLETED

Map No. 11 Sec. 33 Twp. 27 R. 6E

Well No. 4 Shriver

Cromwell & Lewis etal Company

Contractor

FIRST REPORT

SECTION PLAT

NE NE SE

			o

330 Ft. from N. Line

\_\_\_\_\_ Ft. from S. Line

330 Ft. from E. Line

\_\_\_\_\_ Ft. from W. Line

MISCELLANEOUS

Location \_\_\_\_\_

Rig up \_\_\_\_\_

Drilling and Remarks:

Material

RECORD

Cased \_\_\_\_\_ in., \_\_\_\_\_ ft.

Sand \_\_\_\_\_

Gas \_\_\_\_\_

Oil \_\_\_\_\_

Total Depth \_\_\_\_\_

PRODUCTION

1st 24 hrs. Nat. \_\_\_\_\_

1st 24 hrs. after shot \_\_\_\_\_

Gas \_\_\_\_\_ Cu. Ft.

Dry Hole \_\_\_\_\_

Abandoned \_\_\_\_\_

Date

OCT 16 1940 19

S. J. LEWIS Scout

Map No. // Sec. 33 Twp. 27 R. 6E

Well No. 1 Shawver

Cromwell & Lewis etal Company

CORRECTION Contractor

NE SE

SECTION PLAT

330 Ft. from N. Line

Ft. from S. Line

330 Ft. from E. Line

Ft. from W. Line

			o

MISCELLANEOUS

Location

Rig up

Drilling and Remarks:

Reported as

#4 Shriver

RECORD

Cased in., ft.

Sand

Gas

Oil

Total Depth

PRODUCTION

1st 24 hrs. Nat.

1st 24 hrs. after shot

Gas Cu. Ft.

Dry Hole

Abandoned

Date

OCT 31 1940

19

S. J. LEWIS Scout

Map No. 11 Sec. 33 Twp. 27 R. 6E

Well No. 1 Shriver

Cromwell & Lewis etal Company

Contractor

COMPLETED

SECTION PLAT

NE NE SE  
330 Ft. from N. Line

\_\_\_\_\_ Ft. from S. Line

330 Ft. from E. Line

\_\_\_\_\_ Ft. from W. Line

			o

MISCELLANEOUS

Location \_\_\_\_\_

Rig up \_\_\_\_\_

Drilling and Remarks:

*Viola 3093*  
*5" @ 3083*  
*500 acid*  
*Pump 20 ft*

*395 Gr*

RECORD

Cased \_\_\_\_\_ in., \_\_\_\_\_ ft.

Sand \_\_\_\_\_

Gas \_\_\_\_\_

Oil \_\_\_\_\_

Total Depth 3095-

PRODUCTION

1st 24 hrs. Nat. \_\_\_\_\_

1st 24 hrs. after shot \_\_\_\_\_

Gas \_\_\_\_\_ Cu. Ft.

Dry Hole \_\_\_\_\_

Abandoned \_\_\_\_\_

Date

DEC 4 1940

S. J. LEWIS Scout