

Section 11 Township 18 Range 14WWell No. #1 Miller "L"Company Cities Service

NORTH

0							

WEST

EAST

SOUTH

KANSAS

Barton

Sec. 11 Twp. 18 R. 14th

Well No. #1 Miller "L" Farm

Cities Service Company

Boyd Contractor

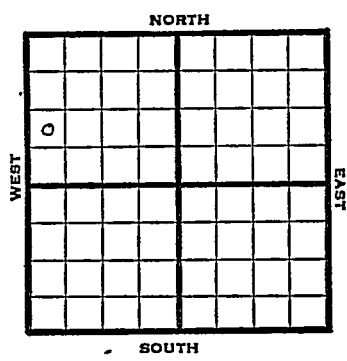
 Ft. from N. Line

990 Ft. from S. Line

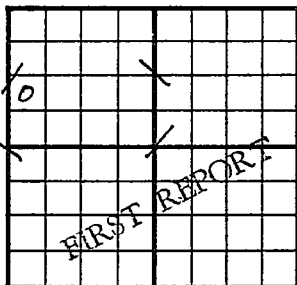
 Ft. from E. Line

330 Ft. from W. Line

NW SW NW



1950	Elev 1913	REPORT
9/13	Location	
11/22	Spud 9-12-50	
	Oil Well TD 3407	
	8" @ 870'	
	Heeb 3032' Dodge 3092'	
	Lans. 3164' Cong 3378'	
	TD 3407' Arb. 3402'	
	DST 3403-07 opn 1/2 hr	
	Rec. 118' mud & oil 5" @3403'	
	FU 100' oil 2 hr 500 A	
	P/10 BO 8 BW 8 hr	
	Comp. 10 BOPD 32 BWPD	
	COMPLETED	

County Barton State KansasSec. 11 (Blk. Twp.) 18 (Sur. Rge.) 14W Map No.Operator Cities ServiceWell No. 1 Farm Miller "L"Elev. 1913 Location NW SW NW990 Ft. From S Line NW380 Ft. From W Line Quarter1st. Report SEP 13 1950

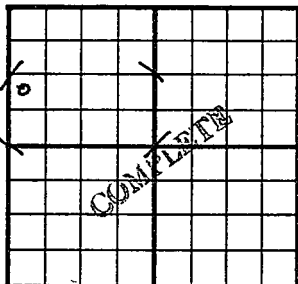
Completion

Remarks

Spudding Date

Drlg. Data Boyd PoolLocation

J. E. TYRA

County Barton State KansasSec. 11 (Blk.
Twp.) 18 (Sur.
Rgs.) 14W Map No.Operator Cities ServiceWell No. 1 Farm Miller "L"Elev. 1913 Location NW SW NW990 Ft. From S Line NW330 Ft. From W Line Quarter1st. ReportCompletion NOV 22 1950Remarks Boyd PoolSpudding Date 9-12-50Drlg. Data Oil well TD 34078" @ 870 Heeb. 3032 Dodge 3092Lans. 3164 Cons. 3378 TD 3407Arb. 3402 DST 3403-07 open $\frac{1}{2}$ hr.Rec. 118' mud & oil 5" @ 3403FU 100' oil 2 hr. 500 A P/ 10 bo 8 bw8 hr. Comp. 10 bopd 32 bwpd-

J. E. TYRA