


Ellis

KANSAS

SECTION 32 TOWNSHIP 13 RANGE 16 W

WELL NO. #1 Dinkel

COMPANY Carl Todd Drlg.

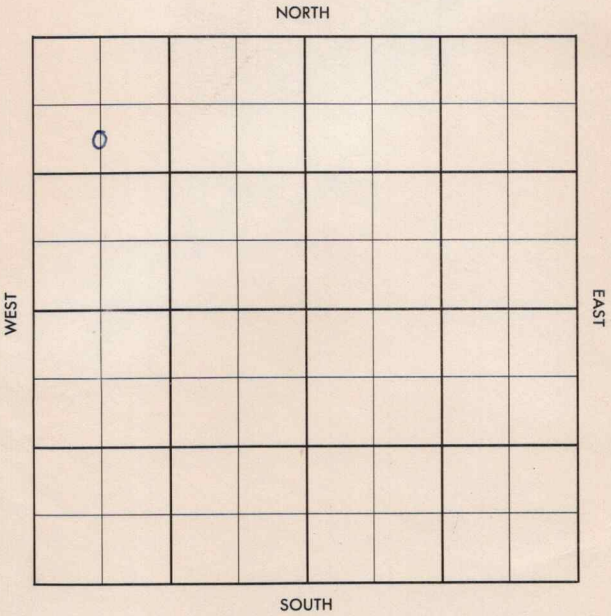

Ellis

KANSAS

SEC.	TWP.	R.
32	13	16W

WELL NO.

#1 Dinkel

FARM

COMPANY

Carl Todd Drlg.

CONTRACTOR

Co. Tools


Herzog

Ft. from N. Line

Ft. from S. Line

Ft. from E. Line

Ft. from W. Line

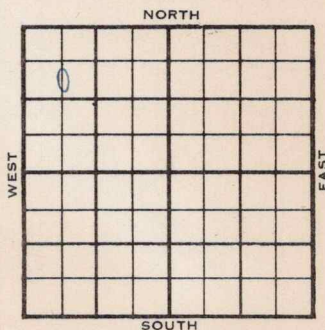C S $\frac{1}{2}$ NW NW

	ELEVATION	REPORT
1955	1923'	
12-1	RUR	
<u>1956</u>		
1-25	Comm. 12-19-55 8 5/8" @ 190/150 DST 3194-3214 op 1 hr. gas to surface in 50 min. rec. 690' oil, 785# DST 3218-43 op $\frac{1}{2}$ hr. rec. 6' drlg. mud O# 5 $\frac{1}{2}$ " @ 3499/125 CO to 3466 10/ 3206-09, 1500 A S/ 22bfph, 10% wtr. Comp. 488 bopd, 12% wtr. H. 3132 L. 3174 A. 3499 TD 3500'	

COMPLETED

County **Ellis** Elev. _____
 Sec. **32** Twp. **13** Rge. **16W**
 Company **Carl Todd Drlg.**
 Farm Name **Dinkel** No. **1**

TOPS	DEPTH	LOG	DATUM	Loc. in Sec.
Anh.				C S$\frac{1}{2}$ NW NW
Tp.				
H.				
Tr.				
Dg.				
B.L.				
L.				Geol. _____
K.C.				Contr. _____
B.K.C.				Co. tools
Ce.				
C.				
M.				
M.				Pool _____
K.				Herzog
Mz.				
Mq.				
V.				
S.				
S.				
A.				
R.				
Pe.				
G.				
ED.				

FIRST REPORT

DEC 21 1955

Date Comm.
RUR

Co.

Lse.

No.

Sec.

T.

R.

County Ellis Elev. 1923
 Sec. 32 Twp. 13 Rge. 16W
 Company Carl Todd Drlg.
 Farm Name Dinkel No. 1

TOPS	DEPTH	LOG	DATUM	Loc. in Sec.
Anh.				C S $\frac{1}{2}$ NW NW
Tp.				
H.	<u>3132</u>			
Tr.				
Dg.				
BL.				
L.	<u>3174</u>		<u>1251</u>	Geol.
K.C.				Contr.
B.K.C.				Co. tools
Ce.				
C.				
M.				Pool
M.				Herzog
K.				
Mz.				
Mq.				
V.				
S.				
S.				
A	<u>3499</u>		<u>1576</u>	
R.				
PE.				COMPLETE
G.				
T.D.	<u>3500</u>			

Date Comm. 12-19-55 JAN 25 1956

8 5/8" @ 190/150 DST 3194-3214

open 1 hr. gas to surface in 50 min.

rec. 690' oil 785# DST 3218-43

open $\frac{1}{2}$ hr. rec. 6' drlg. mud 0#

TD 3500 5 $\frac{1}{2}$ " @ 3499/125 CO to 3466

10/3206-09 1500 A S/ 22 bfph

10% wtr. Comp. 488 bopd 12% wtr.