


Section 3 Township 31 Range 4E

Well No. 4 WattB"

Company H. H. Blair

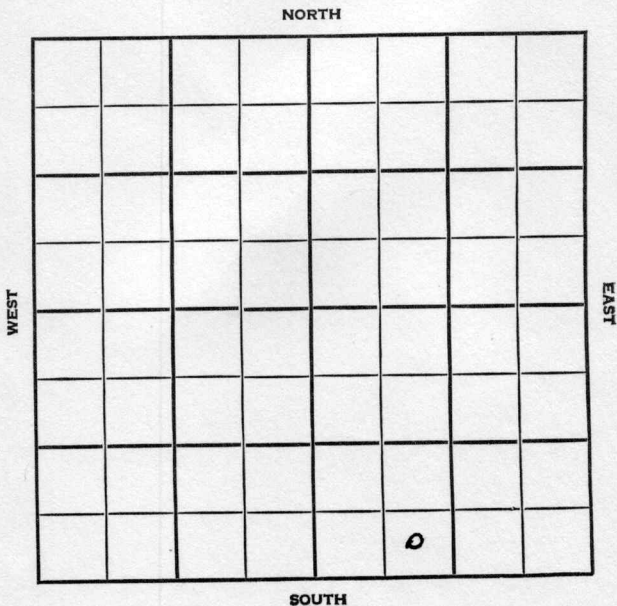

SEC.	TWP.	R.
3	31	4 E

WELL NO. # 4 Watt "B" FARM

COMPANY H. H. Blair

CONTRACTOR

NW David Pool


_____ Ft. from N. Line

330 _____ Ft. from S. Line

_____ Ft. from E. Line

990 _____ Ft. from W. Line

SE SW SE

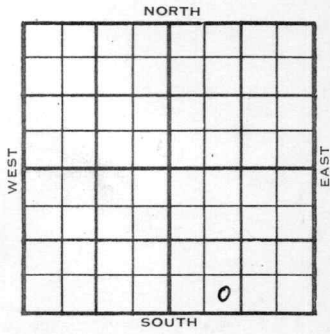

	ELEVATION	REPORT
1954	1216	

5/26
8/4

Location
 Spdg 6-24-54
 Oil well
 TD 2933
 8" @ 90
 Bart 2921
 TD 2927
 5" @ 2924
 DD 2933 FU 175' oil 2 hr. frac F/50
 boph Comp. 25 bopd.

COMPLETED

