
FORM 51 5M BRIX KANSAS

Barton

Section 12 Township 18 Range 14W

Well No. #2 Eveleigh "B"

Company Cities Service Oil

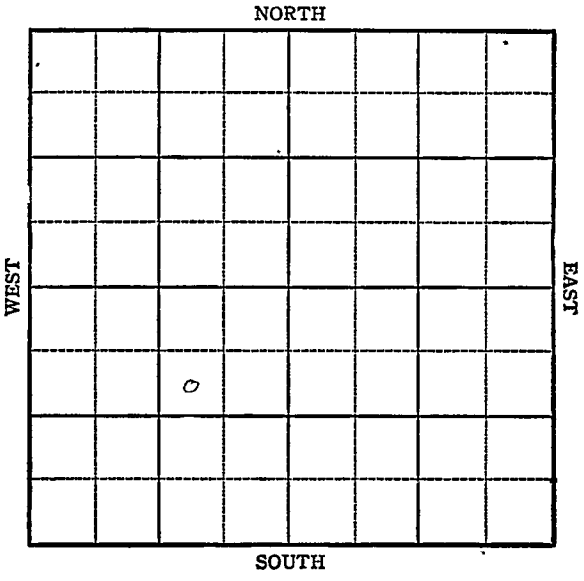

FORM 252-A
5M 3-44 PETROL

KANSAS

Barton

Sec. 12 Twp. 18 R. 14W

Well No. #2, Eveleigh "B" Farm

Cities Service Oil Company


Boyd

990 Ft. from N. Line

Ft. from S. Line

990 Ft. from E. Line

Ft. from W. Line

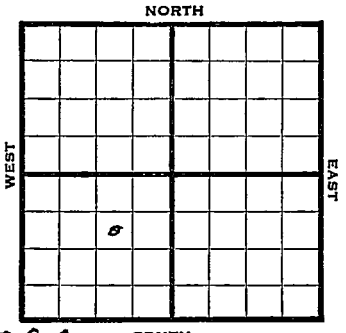

Elev. 1886

1944	REPORT
6/14	Rotary
6/21	8" @ 820 Drlg. 2100
7/5	Arb. 3387 TD 3417

ABANDONED

FORM 26 200 BKS. 2-44 PETROL

KANSAS

Pool Name Boyd

Map No. 73 Sec. 12 Twp. 18 R. 14W

Well No. 2 Eveleigh "B"

Cities Service Oil Company

FIRST REPORT

Contractor

SW NE SW


990 Ft. from N. Line

Ft. from S. Line

990 Ft. from E. Line

Ft. from W. Line

SECTION PLAT

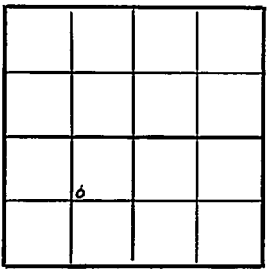

Barton County

Location

Rig up

Drilling and Remarks:

Rotary

RECORD

Cased in., ft.

Sand

Gas

Oil

Total Depth

PRODUCTION

1st 24 hrs. Nat.

1st 24 hrs. after shot

Gas Cu. Ft.

Dry Hole

Abandoned

Date

JUN 14 1944 19

S. J. LEWIS Scout

FORM 26 200 BKS 1-44 PETROL

KANSAS

Pool Name Boyd

Map No. 13 Sec. 12 Twp. 18 R. 14W

Well No. 2 Eveleigh "B"

Cities Service Oil Company

ABANDONED Contractor

SW NE SW

990 Ft. from N. Line


Ft. from S. Line

990 Ft. from E. Line

Ft. from W. Line

Barton County

SECTION PLAT

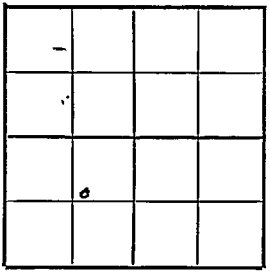

Location

Rig up

Drilling and Remarks:

Cir #3387

RECORD

Cased in., ft.

Sand

Gas

Oil

Total Depth 3417

PRODUCTION

1st 24 hrs. Nat.

1st 24 hrs. after shot

Gas Cu. Ft.

Dry Hole

Abandoned

Date

JUL 5 1944 19 S. J. LEWIS Scout