


Section 32 Township 13 Range 16W

Well No. 1 Dinkel

Company N C R A

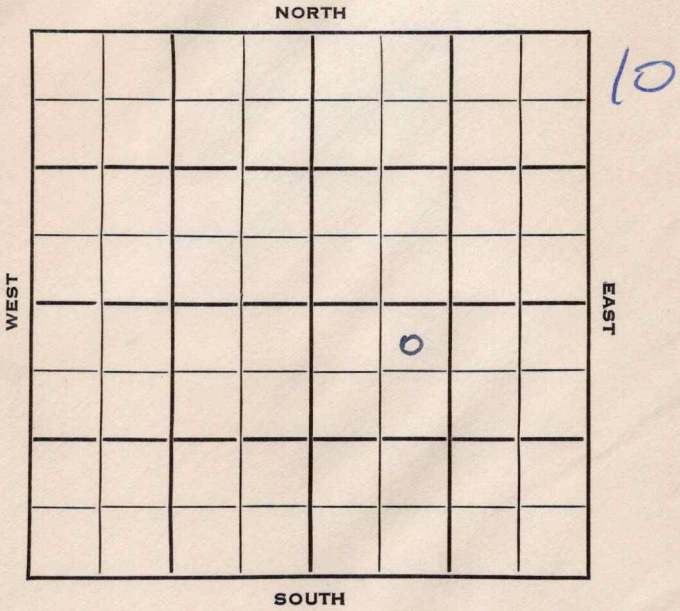

Ellis

KANSAS

SEC.	TWP.	R.
32	13	16 W ✓

WELL NO. # 1 Dinkel FARM

COMPANY N C R A


CONTRACTOR Nye

330 Ft. from N. Line

Ft. from S. Line

Ft. from E. Line

990 Ft. from W. Line

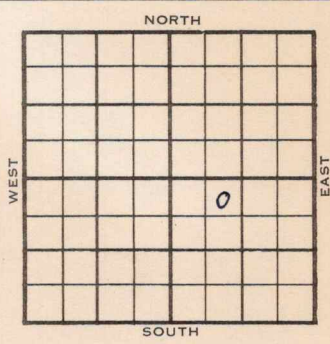

NE NW SE

	ELEVATION	REPORT
1954	1914'	

2/17	MIR
2/24	8" @ 187 w/135 Anhy 1026' Drlg. 3010'
3/3	Spud 2-15-54 D&A TD 3505' 8" @ 187' Anhy 1026', Heeb 3125', Lans 3172' DST 3230-3302', opn 2 hrs., rec. 30' wtr, 310# Cong 3420', Arb. 3436' DST 3437-45', opn 2 hrs., rec. 15' wtr, 655# TD 3505' D&A

**ABANDONED**



