

Section 5 Township 31 Range 4E

Well No. #1 Clark

Company Continental

Miscellaneous

NORTH

WEST

EAST

0							

SOUTH

KANSAS Cowley

✓

Sec. 5 Twp. 31 R. 4E

Well No. #1 Clark Farm

Continental Company
Misc.


330 Ft. from N. Line

Ft. from S. Line

Ft. from E. Line

330 Ft. from W. Line

NW/c

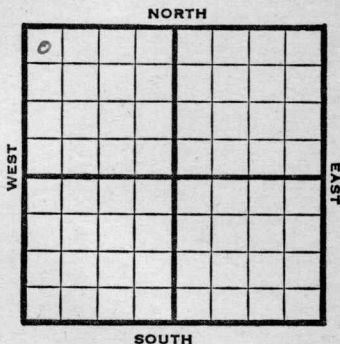

1947 Elev. 1147' REPORT

10/15 Location

10/22 RUR

10/29 12" @ 193'
Drlg. 242'

11/12 Miss. 2880'
Arbuckle 3260'
Total Depth 3280'

ABANDONED

Map No. _____ Sec. 5 Twp. 31 R. 4E

Well No. 1 Clark

Continental Company

FIRST REPORT Contractor

NW/C


SECTION PLAT

330 Ft. from N. Line

_____ Ft. from S. Line

_____ Ft. from E. Line

330 Ft. from W. Line

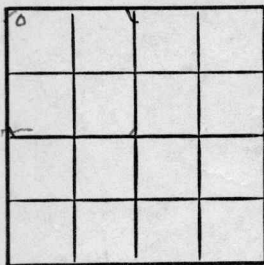

Cowley County

Location X

Rig up _____

Drilling and Remarks:

RECORD

Cased _____ in., _____ ft.

Sand _____

Gas _____

Oil _____

Total Depth _____

PRODUCTION

1st 24 hrs. Nat. _____

1st 24 hrs. after shot _____

Gas _____ Cu. Ft.

Dry Hole _____

Abandoned _____

Date

OCT 15 1947 19 _____ S. J. LEWIS Scout

Map No. 2 Sec. 5 Twp. 31 R. 4E

Well No. 1 Clark

Continental Company

ABANDONED

Contractor

NW/C

E11142
SECTION PLAT

330 Ft. from N. Line

 Ft. from S. Line

 Ft. from E. Line

330 Ft. from W. Line

6			

Cowley County

Location

Rig up

Drilling and Remarks:

Miss 2580

CR 8260

RECORD

Cased in., ft.

Sand

Gas

Oil

Total Depth 3280

PRODUCTION

1st 24 hrs. Nat.

1st 24 hrs. after shot

Gas Cu. Ft.

Dry Hole

Abandoned

Date

NOV 12 1947

19

S. J. LEWIS

Scout