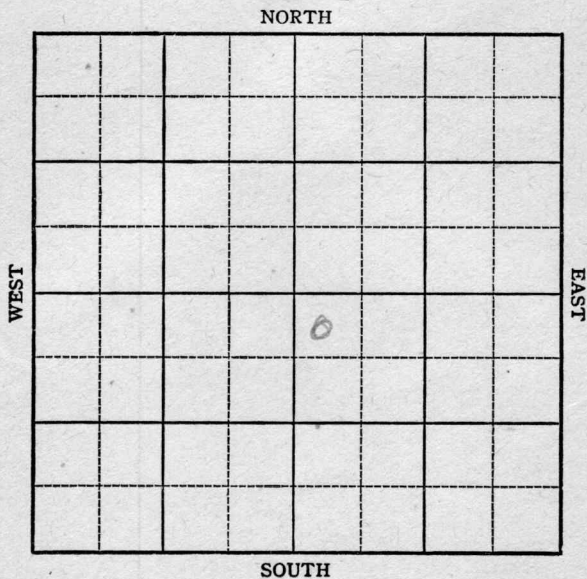


Section 5 Township 31 Range 4-EWell No. #1, MoyleCompany H. H. Blair

KANSAS

Cowley County

Sec. 5 Twp. 31 R. 4E

Well No. 1 Moyle Farm

H. H. Blair Company


Miscellaneous

330 Ft. from N. Line

         Ft. from S. Line

         Ft. from E. Line

330 Ft. from W. Line

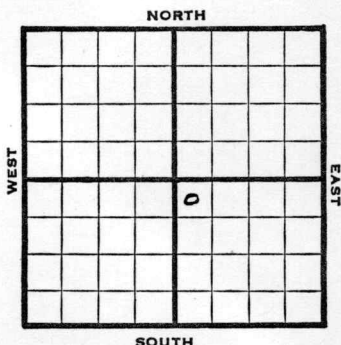

NW SE

1947 Elev. 1170 REPORT


1/2 8" @ 65'  
Drlg 1610'  
1/8 KC 2306'  
Bart 2836'  
Miss 2938'  
Drlg 2940'  
1/15 Arb 3288'  
TD 3299

ABANDONED

Map No. 2 Sec. 5 Twp. 31 R. 4EWell No. 1 MoyleH. H. Blair CompanyFIRST REPORT Contractor

NW SE

## SECTION PLAT

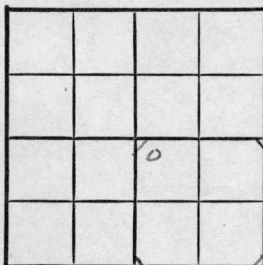330 Ft. from N. Line       Ft. from S. Line       Ft. from E. Line330 Ft. from W. LineCowley CountyLocation                                 Rig up                                 

Drilling and Remarks:

8" @ 65  
drlg. 1610

## RECORD

Cased            in.,            ft.Sand                                 Gas                                 Oil                                 Total Depth                                 

## PRODUCTION

1st 24 hrs. Nat.                                 1st 24 hrs. after shot                                 Gas                                  Cu. Ft.Dry Hole                                 Abandoned                                 

Date

JAN 2 1947 19S. J. LEWIS Scout

Map No. 2 Sec. 5 Twp. 31 R. 4EWell No. 1 MoyleH. H. Blair Company

ABANDONED

Contractor

NW SE

E1,170  
SECTION PLAT330 Ft. from N. Line       Ft. from S. Line       Ft. from E. Line330 Ft. from W. Line

|  |  |   |  |
|--|--|---|--|
|  |  |   |  |
|  |  |   |  |
|  |  | 6 |  |
|  |  |   |  |

Cowley County

Location                     Rig up                     Drilling and Remarks:  
✓ Cor 8288

## RECORD

Cased            in.,            ft.Sand                     Gas                     Oil                     Total Depth 3299

## PRODUCTION

1st 24 hrs. Nat.                     1st 24 hrs. after shot                     Gas                      Cu. Ft.Dry Hole                     Abandoned                     

Date

JAN 15 1947 19S. J. LEWIS Scout